

LINCOLN
 Q 2043

MISSISSIPPI DEPARTMENT OF NATURAL RESOURCES
 Bureau of Land and Water Resources
 Southport Mall
 P.O. Box 10631
 Jackson, Mississippi 39209
WATER WELL DRILLERS LOG

5-19 1987 Fitzgerald Well Serv Lincoln
 date well completed firm name county well located

LANDOWNER:	description of formations encountered	from	to
Kyle Hux R.B. Brazzichetto, Jr. (mailing address)			
WELL LOCATION: sec. <u>25</u> T <u>5</u> N R <u>8</u> E S W <u>12</u> miles <u>E</u> of <u>Summit</u> (distance) (direction) (nearest town)			
WELL PURPOSE: (home, irrigation, municipal, industrial) <u>Home</u>			
WELL COMPLETION DATA:			
(1) diameter (inches) <u>4</u>			
(2) total depth (feet) <u>170</u>			
(3) static water level (feet) <u>80</u> below above top of ground.			
(4) casing <u>PVC, 160</u> (material) (depth) <u>4</u> if telescope see back. (size)			
(5) screen <u>10, 160</u> (length) (depth to top) <u>4</u> (size) <u>PVC</u> (material)			
(6) pump <u>1/2</u> <u>10</u> (HP) (yield gpm) <u>Electric</u> (type power)			
(7) electric log <u>No</u> (yes or no) (organization running log)			
(8) how well bottom plugged <u>Sand plug</u>			


RECEIVED
 JUN 7 5 1987

Department of Natural Resources
 Bureau of Land and Water Resources

DRILLERS REMARKS:

If well telescopes please sketch and show depths.

GROUND LEVEL

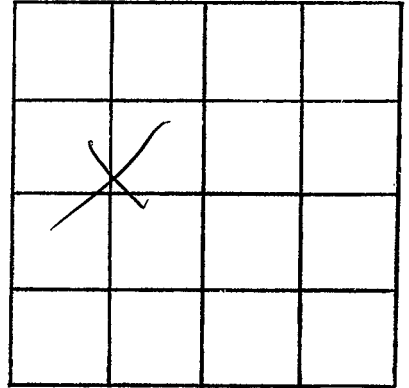

SECTION 25

Please indicate well location X.

ADDITIONAL INFORMATION

If more than one screen,
show locations of each on sketch.