

LINCOLN
CD 2052

MISSISSIPPI DEPARTMENT OF NATURAL RESOURCES
Bureau of Land and Water Resources
Southport Mall
P.O. Box 10631
Jackson, Mississippi 39209
WATER WELL DRILLERS LOG

10-3 1992 F. J. Gagnard Well Serv Lincoln
date well completed firm name county well located

LANDOWNER:
Jerry Rayburn
RR - Summit ms.
(mailing address)

description of formations encountered	from	to
<u>Red clay</u>	<u>0</u>	<u>25</u>
<u>Red sand</u>	<u>25</u>	<u>70</u>
<u>white clay</u>	<u>70</u>	<u>120</u>
<u>Fine Sand</u>	<u>120</u>	<u>125</u>
<u>Coarse Sand & gravel</u>	<u>125</u>	<u>137</u>

WELL LOCATION:
sec 31 T 5 N R 8 E
S W
5 miles NE of JOHNSON STA.
(distance) (direction) (nearest town)

WELL PURPOSE: Home
(home, irrigation, municipal, industrial)

WELL COMPLETION DATA:

- (1) diameter (inches) 4
- (2) total depth (feet) 137
- (3) static water level (feet) 59 below above top of ground.
- (4) casing PVC, 127,
(material) (depth)
4 if telescope see back.
(size)
- (5) screen 10, 127
(length) (depth to top)
4, PVC
(size) (material)
- (6) pump 1/2, 10
(HP) (yield gpm)
elec
(type power)
- (7) electric log no
(yes or no)
(organization running log)
- (8) how well bottom plugged Sand block

DRILLERS REMARKS:

RECEIVED

NOV 27 1990

Department of Natural Resources
Bureau of Land & Water Resources


RECEIVED

NOV 27 1990

Department of Natural Resources
Bureau of Land & Water Resources

If well telescopes please sketch and show depths.

GROUND LEVEL

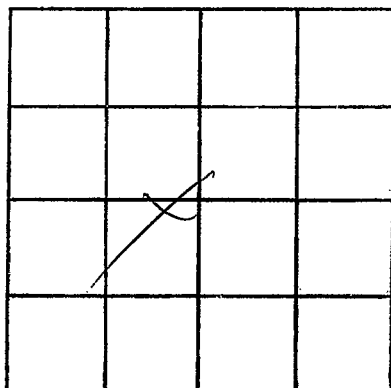

SECTION 31

Please indicate well location X.

ADDITIONAL INFORMATION

If more than one screen,
show locations of each on sketch.