

**MISSISSIPPI DEPARTMENT OF ENVIRONMENTAL QUALITY**  
Bureau of Land and Water Resources

P. O. Box 10631  
Jackson, MS 39289-0631  
**WATER WELL DRILLERS LOG**

COUNTY WELL LOCATED <b>Lincoln</b>	
WELL NUMBER <b>2056</b>	CODED
DATE WELL COMPLETED <b>7-16-93</b>	

PERMIT NUMBER
NAME OF DRILLING FIRM <b>Green Water Well</b>
<b>o Supply</b>

NAME & MAILING ADDRESS OF LANDOWNER <b>John Henry Hall</b>			
<b>Rt 1 Box 49</b>			
<b>Boquechitto MS</b>			
WELL LOCATION:	SEC	TOWNSHIP	RANGE
	<b>17</b>	<b>5</b>	<b>8</b>
		<b>N</b>	<b>W</b>
DISTANCE	DIRECTION	NEAREST TOWN	
<b>3</b> Miles	<b>SE</b>	of <b>Boquechitto</b>	
OTHER LANDMARK			
WELL PURPOSE: Home, Irrigation, Municipal, Industrial, Fish Pond, etc. <b>Chicken Houses</b>			

<b>PUMP DATA</b>		
PUMP TYPE (Circle One): <input checked="" type="radio"/> <b>Submersible</b> Turbine, Jet, Flowing Well, Other (Describe) _____		
POWER TYPE (Circle One): <input checked="" type="radio"/> <b>Electric</b> Tractor, Diesel, Gasoline, Butane, Other (Describe) _____ H/P <b>1 1/2</b>		
Pump Capacity (GPM) <b>16</b>	No. of Stages	Setting Depth <b>65</b> FT.
PUMP TEST		
Well yielded <b>16</b> GPM with a drawdown of <b>0</b> ft. after _____ hours of pumping		

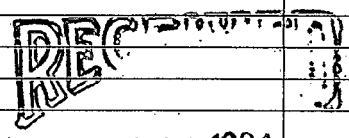
<b>WELL DATA</b>		
Well Depth <b>104</b>	Casing Diameter (In.) <b>4 in.</b>	Casing Length (Ft.) <b>94</b>
Type of Casing <b>PVC</b>	Hole Depth <b>108</b>	Depth to Static Water Level <b>30</b>
TYPE OF COMPLETION: (Circle One or More): <input checked="" type="radio"/> <b>Gravel Packed</b> , Underreamed, Telescoped, Natural Development, Open Hole, Other (Describe) _____		
Top of Lap Pipe or Reduction in Casing		
FEET IF TELESCOPED OR MORE THAN ONE SCREEN: USE BACK PAGE		

<b>LOG DATA</b>	
TYPE OF LOG RUN (Circle One): <input checked="" type="radio"/> <b>No Log Run</b> , Electric, Gamma Ray, Density, Sonic, Neutron, Other (Describe) _____	
Name of Organization Running Log	

<b>SCREEN DATA</b>		
Diameter - Inches <b>4 in.</b>	Length - Feet <b>10 ft.</b>	Slot Size - Inches <b>.010</b>
Screen Type <b>PVC</b>	Depth to Bottom - Feet <b>104</b>	

<b>GEOLOGIC DATA (Office Use Only)</b>			
Surface Elev.	Geologic Unit	Unit Thickness	Depth to Top
Subs. SWL	Date	Analysis	Aquifer Test

Driller's Remarks

DESCRIPTION OF FORMATIONS ENCOUNTERED	FROM	TO	FORMATIONS (Continued)	FROM	TO
<b>Clay</b>	<b>0</b>	<b>16</b>	 <b>JUL 01 1994</b> Dept. of Environ. Quality Office of Land & Water Resources		
<b>Sand &amp; Gravel</b>	<b>16</b>	<b>41</b>			
<b>Clay</b>	<b>41</b>	<b>79</b>			
<b>Coarse Sand</b>	<b>79</b>	<b>104</b>			
<b>Clay</b>	<b>104</b>	<b>108</b>			

IF MORE SPACE IS NEEDED, USE BACK

If well telescopes please sketch and show depths.

GROUND LEVEL

		X	

SECTION 17

Please indicate well location X.

ADDITIONAL INFORMATION

If more than one screen,  
show location of each on sketch.