

**CODED**  
 Lincoln  
 ER2  
 12-67

MISSISSIPPI  
 BOARD OF WATER COMMISSIONERS  
 416 North State Street  
 Jackson, Mississippi 39201

**CODED**

WATER WELL DRILLERS LOG

12-12 date well completed      Fitzgerald Water Well firm name      Lincoln county well located

LANDOWNER: Sidney Smith  
Ruth Rt MISS  
 (mailing address)

description of formations encountered	from	to
Top soil & clay	0	14
Red sand	14	55
Chalk white	55	80
fine sand	80	110
sand & gravel	110	120


WELL LOCATION:  
 sec. 14 T. 9 N. R. 6 E.  
2 miles NE of Ruth  
 (distance) (direction) (nearest town)

WELL PURPOSE: Home  
 (home, irrigation, municipal, industrial)

WELL COMPLETION DATA:

- (1) diameter (inches) 4
- (2) total depth (feet) 120
- (3) static water level (feet) 60 below above top of ground.
- (4) casing plastic 114  
 (material) (depth)  
4 If telescope see back.  
 (size)
- (5) screen 6' 114  
 (length) (depth to top)  
4 plastic  
 (size) (material)
- (6) pump — —  
 (HP) (yield gpm)  
Elec  
 (type power)
- (7) electric log no  
 (yes or no)  
 (organization running log)
- (8) how well bottom plugged good peg

**CODED**

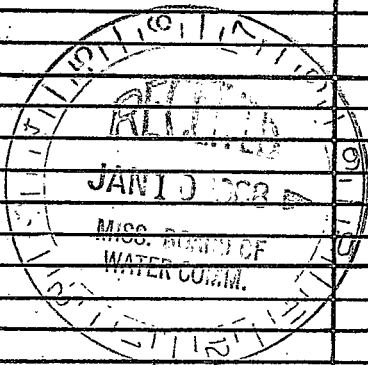

DRILLERS REMARKS:

If well telescopes please sketch and show depths.

GROUND LEVEL

	X		

SECTION 14

Please indicate well location X.

ADDITIONAL INFORMATION

If more than one screen, show locations of each on sketch.