

Lincoln  
 RA CODED  
 10-67

MISSISSIPPI  
 BOARD OF WATER COMMISSIONERS  
 416 North State Street  
 Jackson, Mississippi 39201

WATER WELL DRILLERS LOG

Oct 17 1967 Reverwell Drilling Lincoln  
 date well completed firm name county well located

LANDOWNER: Smithlyland  
Ruth Miss  
 (mailing address)

description of formations encountered	from	to
Red clay	0	1.5
Red sand	1.5	3.2
pink & white chalk	3.2	1.50
Red gravel sand	1.50	1.59

WELL LOCATION:  
 sec. 21 T. 5 N R. 9 E  
1/4 miles NE of Ruth  
 (distance) (direction) (nearest town)


WELL PURPOSE: Home  
 (home, irrigation, municipal, industrial)

WELL COMPLETION DATA:  
 (1) diameter (inches) 4"  
 (2) total depth (feet) 1.59  
 (3) static water level (feet) 30 above top of ground.  
 (4) casing Plastic Galvan  
 (material) (depth)  
 \_\_\_\_\_ if telescope see back.  
 (size)  
 (5) screen 6' 1.53'  
 (length) (depth to top)  
4" Plastic  
 (size) (material)  
 (6) not installed  
 (HP) (yield gpm)

(type power)  
 (7) electric log \_\_\_\_\_  
 (yes or no)  
 (organization running log)

(8) how well bottom plugged wooden plug


DRILLERS REMARKS:  
New house

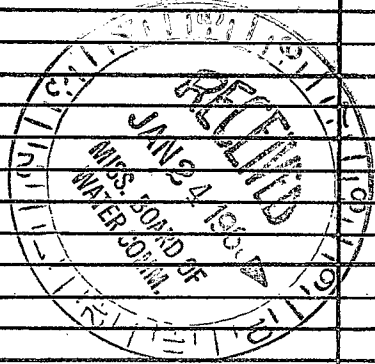

CODED

If well telescopes please sketch and show depths.

GROUND LEVEL

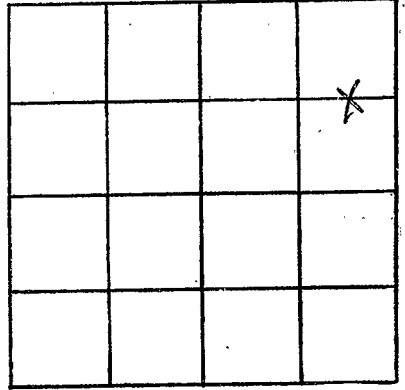

SECTION 21

Please indicate well location X.

ADDITIONAL INFORMATION

If more than one screen, show locations of each on sketch.