

Lincoln  
R5  
12-60  
CODED

MISSISSIPPI  
BOARD OF WATER COMMISSIONERS  
416 North State Street  
Jackson, Mississippi 39201

WATER WELL DRILLERS LOG

12 3 1969 date well completed  
69 Fitzgerald Water Well firm name  
Lincoln county well located

LANDOWNER: Alvie Boyd  
Ruth P. Miss

description of formations encountered

from	to
0	8
8	12
12	50
50	90
90	100

(mailing address)


WELL LOCATION:  
sec. 24 T 5 N R 9 E  
S W  
2 miles miles 55E of Ruth  
(distance) (direction) (nearest town)

WELL PURPOSE: Home  
(home, irrigation, municipal, industrial)

WELL COMPLETION DATA:

- (1) diameter (inches) 4
- (2) total depth (feet) 100
- (3) static water level (feet) 50 below/above top of ground.
- (4) casing plastic 4" (material) (depth)  
4 (size) if telescope see back.
- (5) screen 6' (length) 0' (depth to top)  
1/2" (size) 50# 40 (material)
- (6) pump (HP) (yield gpm)  
3/4 (type power)
- (7) electric log no (yes or no)  
(organization running log)
- (8) how well bottom plugged wood peg


CODED

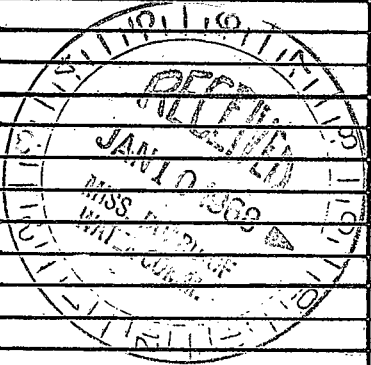

DRILLERS REMARKS:

If well telescopes please sketch and show depths.

GROUND LEVEL

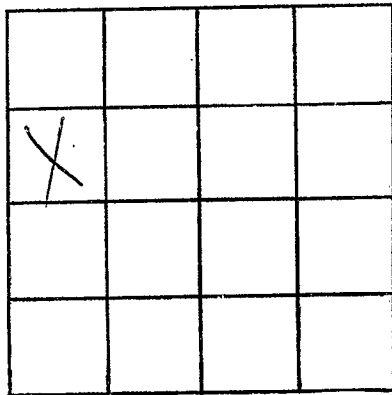

SECTION 34

Please indicate well location X.

ADDITIONAL INFORMATION

If more than one screen, show locations of each on sketch.