

LINCOLN
 R7
 3-68

MISSISSIPPI
 BOARD OF WATER COMMISSIONERS
 416 North State Street
 Jackson, Mississippi 39201

WATER WELL DRILLERS LOG

MARCH 29 1968 Reeves well & pump Lincoln
 date well completed firm name county well located

LANDOWNER: James Dougherty
 RFD, ~~...~~
 (mailing address)

description of formations encountered	from	to
Red clay	0	16
Red sand	16	70
Gravel shell	70	80
Gravel	80	91

WELL LOCATION:
 sec. 3 T-5 N R-9 E
 4.5 miles NE of Ruth
 (distance) (direction) (nearest town)

WELL PURPOSE: Home
 (home, irrigation, municipal, industrial)

WELL COMPLETION DATA:

(1) diameter (inches) 4"

(2) total depth (feet) 91

(3) static water level (feet) 60 below top of ground

(4) casing Plastic Bottoms
 (material) (depth)

(5) screen 6' 8 5/8"
 (length) (depth to top)
 0" Plastic
 (size) (material)

(6) pump 1/2 hp. 5
 (HP) (yield gpm)
 Electric
 (type power)

(7) electric log No
 (yes or no)

(organization running log)

(8) how well bottom plugged
 wooden plug

DRILLERS REMARKS:
 new location


CODED

MAY 27 1968

MISS. BOARD OF WATER COMMISSIONERS

If well telescopes please sketch and show depths.

GROUND LEVEL

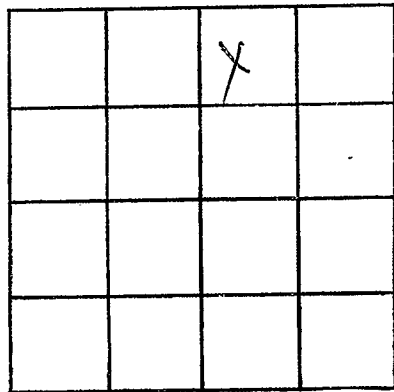

SECTION 3

Please indicate well location X.

ADDITIONAL INFORMATION

If more than one screen,
show locations of each on sketch.