

Lincoln
R 8
6-68
CODED

MISSISSIPPI
BOARD OF WATER COMMISSIONERS
416 North State Street
Jackson, Mississippi 39201

WATER WELL DRILLERS LOG

June 19 1968 Keene Well Drump Lincoln
date well completed firm name county well located

LANDOWNER: C. C. Clark

description of formations encountered from to

Ruth, Miss
(mailing address)

<u>Red clay</u>	<u>0</u>	<u>18</u>
<u>Red sand & shales</u>	<u>18</u>	<u>50</u>
<u>Gravel</u>	<u>50</u>	<u>65</u>
<u>Red cherty sand</u>	<u>65</u>	<u>108</u>
<u>fine yellow sand</u>	<u>108</u>	<u>120</u>
<u>Coarse sand</u>	<u>120</u>	<u>126</u>

WELL LOCATION:
sec. 20 T. 5 N. R. 9 E
at Ruth
(distance) (direction) (nearest town)

WELL PURPOSE: Home
(home, irrigation, municipal, industrial)

WELL COMPLETION DATA:

- (1) diameter (inches) 4"
- (2) total depth (feet) 126 ft.
- (3) static water level (feet) 68 below top of ground.
- (4) casing Plastic Bottom
(material) (depth)

(size) if telescope see back.

- (5) screen 6' 120'
(length) (depth to top)
- 4" Plastic
(size) (material)

- (6) pump old pump installed
(HP) (yield, gpm)
- by auger
(type power) elect

- (7) electric log no
(yes or no)

(organization running log)

- (8) how well bottom plugged wooden plug


DRILLERS REMARKS:
red soil
Bad

CODED

JUL 22 1968
MISS. BOARD OF
WATER COMMISSIONERS

If well telescopes please sketch and show depths.

GROUND LEVEL

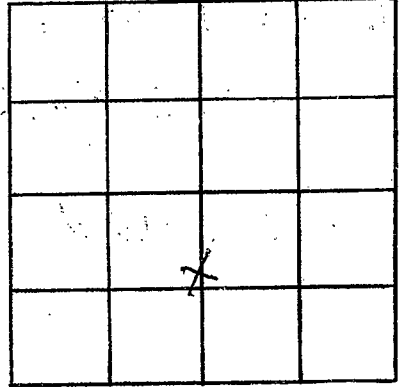

SECTION *20*

Please indicate well location X.

ADDITIONAL INFORMATION

If more than one screen, show locations of each on sketch.