

Lincoln Co  
 R 11  
 7-69

MISSISSIPPI  
 BOARD OF WATER COMMISSIONERS  
 416 North State Street  
 Jackson, Mississippi 39201

CODED

WATER WELL DRILLERS LOG

7-12 19 69 Fitzgerald & Sons Lincoln  
 date well completed firm name county well located

LANDOWNER:  
Anely Owens  
R.R. Ruth, Miss.  
 (mailing address)

description of fomations encountered	from	to
<u>Red clay</u>	<u>0</u>	<u>15</u>
<u>Red sand</u>	<u>15</u>	<u>40</u>
<u>Coarse sand &amp; gravel</u>	<u>40</u>	<u>78</u>

WELL LOCATION:  
 sec. 32 5 N R. 9 E  
2 miles S of Ruth  
 (distance) (direction) (nearest town)

WELL PURPOSE: Home  
 (home, irrigation, municipal, industrial)

- WELL COMPLETION DATA:
- (1) diameter (inches) 4
  - (2) total depth (feet) 78
  - (3) static water level (feet) 40 below above top of ground.
  - (4) casing Plastic 72  
 (material) (depth)  
4 if telescope see back.  
 (size)
  - (5) screen 6 72  
 (length) (depth to top)  
4 plastic  
 (size) (material)
  - (6) pump ? ?  
 (HP) (yield gpm)  
Elco  
 (type power)
  - (7) electric log No  
 (yes or no)  
 (organization running log)
  - (8) how well bottom plugged Goodly

CODED


AUG 4 1969

MISS. BD. OF  
 WATER COMM.

DRILLERS REMARKS:

If well telescopes please sketch and show depths.

GROUND LEVEL

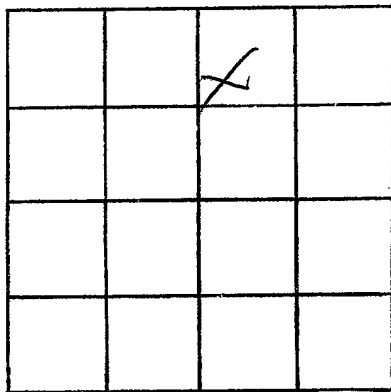

SECTION 32

Please indicate well location X.

ADDITIONAL INFORMATION

If more than one screen,  
show locations of each on sketch.