

Lincoln
R 12
5-1-70

MISSISSIPPI
BOARD OF WATER COMMISSIONERS
416 North State Street
Jackson, Mississippi 39201
RECORDED

WATER WELL DRILLERS LOG

May 1 1970 chester keene Lincoln
date well completed firm name county well located

LANDOWNER: chas. R.
Buster Sr.
Rt 1, Hayers.
(mailing address)

description of formations encountered

from to

red clay 0 17
red sand 17 54
sand & gravel 54 118
red chalk 118 120
gravel & sand 120 131

WELL LOCATION:

sec 36 T 5 N R 9 E 065
3 1/2 miles W of Jones
(distance) (direction) (nearest town)

WELL PURPOSE: Hog Farm
(home, irrigation, municipal, industrial)

WELL COMPLETION DATA:

- (1) diameter (inches) 4"
- (2) total depth (feet) 131
- (3) static water level (feet) 106 below top of ground.
- (4) casing, Plastic Bottom -
(material) (depth)
- (size) if telescope see back.
- (5) screen 6' 125'
(length) (depth to top)
4" Plastic
(size) (material)
- (6) pump 1/2 Sub. B
(HP) (yield gpm)
Sleet
(type power)
- (7) electric log No.
(yes or no)

(organization running log)

- (8) how well bottom plugged -
wooden plug

DRILLERS REMARKS:


new location
for Hog farm.

MAY 14 1970

MISS. BD. OF
WATER COMMISSIONERS

If well telescopes please sketch and show depths.

GROUND LEVEL

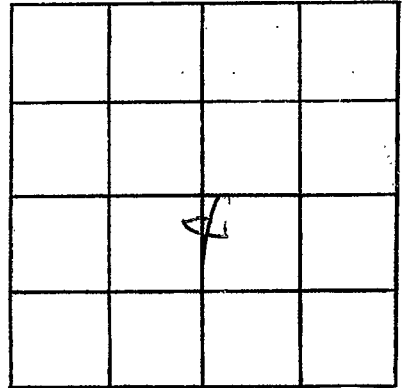

SECTION 36

Please indicate well location X.

ADDITIONAL INFORMATION

If more than one screen, show locations of each on sketch.