

Lincoln
R 13
6-17-70

MISSISSIPPI
BOARD OF WATER COMMISSIONERS
416 North State Street
Jackson, Mississippi 39201

CODED


WATER WELL DRILLERS LOG

June 17 1970 date well completed
Green Water Well Co. firm name
Lincoln county well located

LANDOWNER:	description of formations encountered	from	to
W. L. Boyd Ruth Miss. (mailing address)			
WELL LOCATION:			
sec. <u>29</u> T. <u>5</u> N. R. <u>9</u> E.			
<u>1</u> miles <u>S</u> of <u>Ruth</u> (distance) (direction) (nearest town)			
WELL PURPOSE: <u>Domestic</u> (home, irrigation, municipal, industrial)			
WELL COMPLETION DATA:			
(1) diameter (inches) <u>6 in</u>			
(2) total depth (feet) <u>115</u>			
(3) static water level (feet) <u>55</u> below above top of ground.			
(4) casing <u>PVC</u> , <u>102</u> , (material) (depth). (size) if telescope see back.			
(5) screen <u>4 ft</u> , <u>98 ft</u> (length) (depth to top) <u>010</u> , <u>PVC</u> (size) (material)			
(6) pump <u>no</u> (HP) (yield gpm) (type power)			
(7) electric log <u>no</u> (yes or no) (organization running log)			
(8) how well bottom plugged <u>wood</u>			
DRILLERS REMARKS:			
JUL 2 1970			
MISS. BD. OF WATER COMMISSIONERS			

If well telescopes please sketch and show depths.

GROUND LEVEL

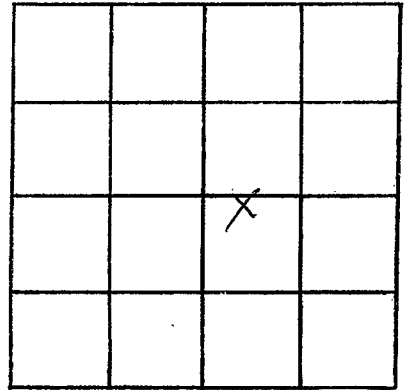

SECTION 29

Please indicate well location X.

ADDITIONAL INFORMATION

If more than one screen,
show locations of each on sketch.