

CODED

MISSISSIPPI
BOARD OF WATER COMMISSIONERS
416 North State Street
Jackson, Mississippi 39201

FEB 19 1971

MISS. BD. OF
WATER COMMISSIONERS

WATER WELL DRILLERS LOG

LINCOLN
R 14
1-18-71

Jan 18 1971 Chester Keenes
date well completed firm name

county well located

LANDOWNER: Phillip Keenes
RFD
Jayes
(mailing address)

description of formations encountered	from	to
chalk	0	10
chalky sand	10	30
chalk	30	70
sand	70	80
chalk	80	100
sand & gravel	100	173

WELL LOCATION:
sec. 36 T-5 N R-9 E
3 1/2 miles W Jayes
(distance) (direction) (nearest town)

WELL PURPOSE: Home
(home, irrigation, municipal, industrial)

- WELL COMPLETION DATA:
- (1) diameter (inches) 4"
 - (2) total depth (feet) 173
 - (3) static water level (feet) 118 below top of ground
 - (4) casing ~~Plast~~ ~~Bottom~~
(material) (depth)
 - (5) screen 6' 11 1/2"
(length) (depth to top)
4" plast
(size) (material)
 - (6) pump ~~sediment~~
(HP) (yield gpm)
owner
(type power)
 - (7) electric log NO
(yes or no)

CODED


(organization running log)

(8) how well bottom plugged
wooden plug

DRILLERS REMARKS:
New house

If well telescopes please sketch and show depths.

GROUND LEVEL

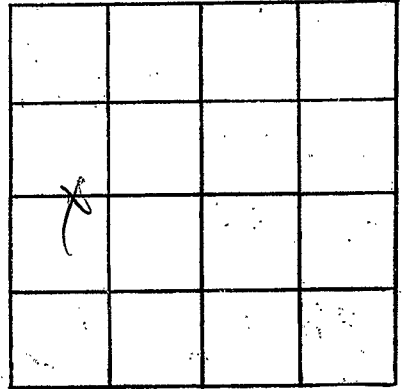

SECTION 36

Please indicate well location X.

ADDITIONAL INFORMATION

If more than one screen, show locations of each on sketch.