

MISSISSIPPI
BOARD OF WATER COMMISSIONERS
416 North State Street
Jackson, Mississippi 39201

CODED

WATER WELL DRILLERS LOG

LINCOLN
R 15
5-24-71

24 May 1971 S & P Water Well Lincoln
date well completed firm name county well located

LANDOWNER:
Roche Honey
Roch
(mailing address)

description of formations encountered	from	to
Clay	0	20
Clay/Clay	20	25
Sand/Clay	25	45
Sand	45	75
Sand/Gravel	75	89

WELL LOCATION:
sec. 26 T 5 N S R 9 E W
(distance) miles (direction) of (nearest town)

WELL PURPOSE:
(home, irrigation, municipal, industrial)

WELL COMPLETION DATA:

(1) diameter (inches) 4"

(2) total depth (feet) 89

(3) static water level (feet) 50 below above top of ground.

(4) casing PI 8.3 (material) (depth) If telescope see back. (size)

(5) screen 6 83 (length) (depth to top)

4 PI (size) (material)

(6) pump 1/2 8 (HP) (yield gpm)
elect (type power)

(7) electric log (yes or no)

(organization running log)

(8) how well bottom plugged wood

CODED


MAY 14 1971

MISSISSIPPI BOARD OF WATER COMMISSIONERS

DRILLERS REMARKS:

If well telescopes please sketch and show depths.

GROUND LEVEL

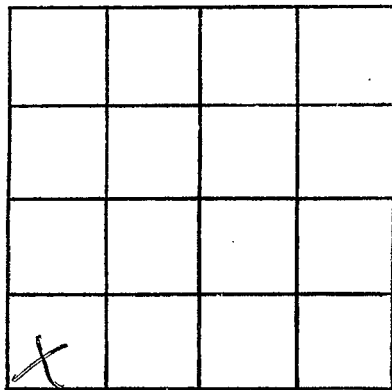

SECTION 26

Please indicate well location X.

ADDITIONAL INFORMATION

If more than one screen,
show locations of each on sketch.