

**CODED**

MISSISSIPPI  
BOARD OF WATER COMMISSIONERS  
416 North State Street  
Jackson, Mississippi 39201

**WATER WELL DRILLERS LOG**

LINCOLN  
R16  
8-21-71

21 Aug 71 date well completed      71 S&P Water firm name      Lincoln county well located

LANDOWNER:  
James Farrington  
Ruth Mc...  
(mailing address)

description of formations encountered	from	to
Clay	0	20
Clay Shale	20	35
Sand + Gravel	35	45

WELL LOCATION:  
sec. 13 T 5 N R 9 E  
3 miles East off Route  
(distance) (direction) (nearest town)

WELL PURPOSE:  
(home, irrigation, municipal, industrial)

- WELL COMPLETION DATA:
- (1) diameter (inches) 4
  - (2) total depth (feet) 45
  - (3) static water level (feet) 60 below top of ground.
  - (4) casing (material) 8-7 (depth)
  - (size) if telescope see back.
  - (5) screen (length) 6 (depth to top) 87
  - (size) (material)
  - (6) pump (HP) (yield gpm)
  - (type power) electric
  - (7) electric log (yes or no)

**CODED**

(organization running log)  
(8) how well bottom plugged Wood


OCT 18 1971

MISS. Bd. OF  
WATER COM.

DRILLERS REMARKS:

If well telescopes please sketch and show depths.

GROUND LEVEL

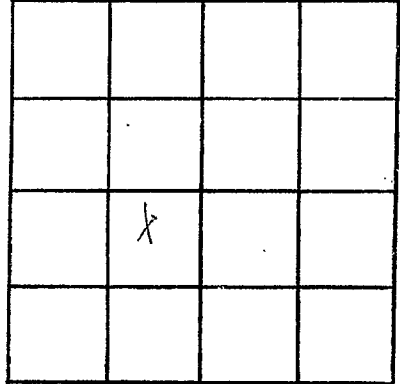

SECTION

13

Please indicate well location X.

ADDITIONAL INFORMATION

If more than one screen,  
show locations of each on sketch.