

LINCOLN
R 17
5-25-72

MISSISSIPPI
 BOARD OF WATER COMMISSIONERS
 416 North State Street
 Jackson, Mississippi 39201

CODED

WATER WELL DRILLERS LOG

May 25 1972 Grenn Water Well Contractor Lincoln
 date well completed firm name county well located


LANDOWNER: <u>Horace Reeves</u>	description of formations encountered	from	to
<u>Bogue Chitto, Miss.</u>			
	<u>clay</u>	<u>106</u>	<u>120</u>
(mailing address)			
WELL LOCATION:			
sec. <u>10</u> T. <u>5</u> N. R. <u>9</u> E			
<u>10</u> miles SE of <u>Brookhaven</u>			
(distance) (direction) (nearest town)			
WELL PURPOSE: <u>home</u> (home, irrigation, municipal, industrial)			
WELL COMPLETION DATA:			
(1) diameter (inches) <u>6"</u>			
(2) total depth (feet) <u>120</u>			
(3) static water level (feet) <u>60</u> below above top of ground.			
(4) casing <u>PVC</u> <u>80'</u> (material) (depth)			
<u>4"</u> If telescope see back. (size)			
(5) screen <u>6"</u> <u>80</u> (length) (depth to top)			
<u>.010</u> <u>PVC</u> (size) (material)			
(6) pump <u>did not install</u> (HP) (yield gpm)			
(type power)			
(7) electric log <u>no</u> (yes or no)			
(organization running log)			
(8) how well bottom plugged <u>wood</u>			
DRILLERS REMARKS:			

CODED

5/28/72

If well telescopes please sketch and show depths.

GROUND LEVEL

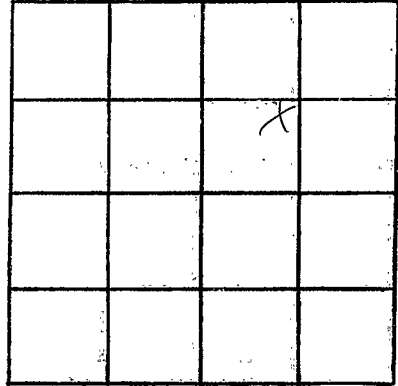

SECTION 9

Please indicate well location X.

ADDITIONAL INFORMATION

If more than one screen,
show locations of each on sketch.