

LINCOLN  
R 19  
8-31-72

MISSISSIPPI  
BOARD OF WATER COMMISSIONERS  
416 North State Street  
Jackson, Mississippi 39201

CODED

WATER WELL DRILLERS LOG

31 Aug 1972 date well completed  
J. T. Langston Lincoln firm name  
Lincoln county well located

LANDOWNER:  
Theophos Helfstanz  
Ruth  
(mailing address)

description of formations encountered	from	to
clay	0	20
bedrock	25	40
fine silica	40	60
chp	60	70
grd	80	115

WELL LOCATION:  
sec. 36 T 9 N R 10 E  
4 miles E of Ruth  
(distance) (direction) (nearest town)

WELL PURPOSE:  
(home, irrigation, municipal, industrial)

WELL COMPLETION DATA:

(1) diameter (inches) ~~4~~ 4 CODED

(2) total depth (feet) 115

(3) static water level (feet) 70 below top of ground

(4) casing (material) PL (depth) 109  
(size) if telescope see back.

(5) screen (length) 6 (depth to top) 109  
(size) 4 (material) PL

(6) pump (HP) 1/2 (yield gpm) 8  
(type power) elect

(7) electric log (yes or no)

(organization running log)


(8) how well bottom plugged mud

DRILLERS REMARKS:

11:1 2/1 1072

If well telescopes please sketch and show depths.

GROUND LEVEL

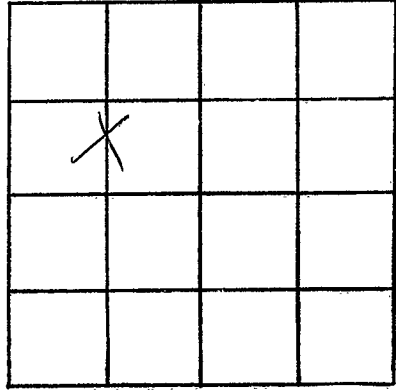

SECTION 36

Please indicate well location X.

ADDITIONAL INFORMATION

If more than one screen,  
show locations of each on sketch.