

LINCOLN
R 21
3-4-74

MISSISSIPPI
BOARD OF WATER COMMISSIONERS
416 North State Street
Jackson, Mississippi 39201

CODED

WATER WELL DRILLERS LOG

March 4 19 74 Green W. W. Co. Lincoln
date well completed firm name county well located

LANDOWNER: Woodie J. Rutland description of formations encountered from to
Ruth Miss. Citronelle 0 105

(mailing address)

WELL LOCATION:

sec. 13 T. 5 N. R. 9 E
5 miles E of Ruth
(distance) (direction) (nearest town)

WELL PURPOSE: home
(home, irrigation, municipal, industrial)

WELL COMPLETION DATA:

- (1) diameter (inches) 6"
- (2) total depth (feet) 105
- (3) static water level (feet) 65 below above top of ground.
- (4) casing PVC, 99,
(material) (depth)
4" if telescope see back.
(size)
- (5) screen 6', 99'
(length) (depth to top)
1010, PVC
(size) (material)
- (6) pump 1/2 sub. 7
(HP) (yield gpm)
electric
(type power)
- (7) electric log no
(yes or no)

(organization running log)

(8) how well bottom plugged wood


DRILLERS REMARKS:

CODED

APR 30 1974
MISS. Bd. of Water Comm.

If well telescopes please sketch and show depths.

GROUND LEVEL

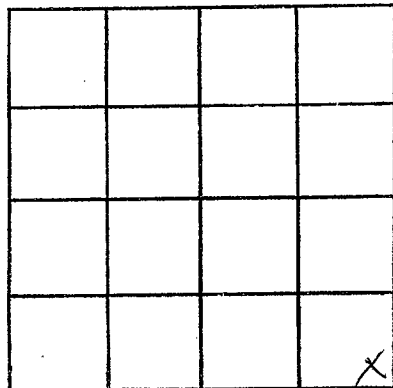

SECTION 12

Please indicate well location X.

ADDITIONAL INFORMATION

If more than one screen,
show locations of each on sketch.