

**LINCOLN**  
**R 22**  
**1-10-74**

MISSISSIPPI  
 BOARD OF WATER COMMISSIONERS  
 416 North State Street  
 Jackson, Mississippi 39201

**WATER WELL DRILLERS LOG**

Jan 10 1974 Green W. C. Lincoln  
 date well completed firm name county well located

LANDOWNER:  
 Buford Thompson  
 Ruth, Miss.  
 (mailing address)

description of formations encountered	from	to
Ostronelle	0	150

WELL LOCATION:  
 sec. 28 T. 5 N R. 9 E  
 2 miles S.E. of Ruth  
 (distance) (direction) (nearest town)

WELL PURPOSE: home  
 (home, irrigation, municipal, industrial)


- WELL COMPLETION DATA:
- (1) diameter (inches) 6"
  - (2) total depth (feet) 150'
  - (3) static water level (feet) 80' below top of ground.
  - (4) casing PVC, 144' (material) (depth)  
 4" (size) if telescope see back.
  - (5) screen 6' (length), 144' (depth to top)  
 10 (size), PVC (material)
  - (6) pump Did not install (HP) (yield gpm)  
 (type power)
  - (7) electric log no (yes or no)  
 (organization running log)
  - (8) how well bottom plugged Wood

RECEIVED  
 APR 30 1974

DRILLERS REMARKS:

If well telescopes please  
sketch and show depths.

GROUND LEVEL

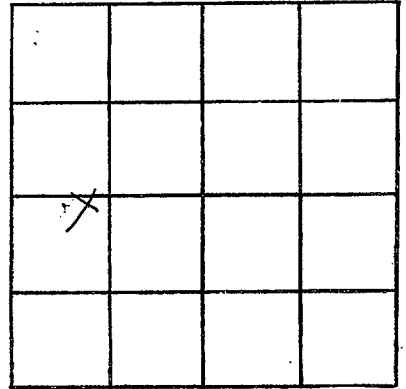

SECTION 28

Please indicate well location X.

ADDITIONAL INFORMATION

If more than one screen,  
show locations of each on sketch.