

CODED

Lincoln
R23
7-18-74

MISSISSIPPI
BOARD OF WATER COMMISSIONERS
416 North State Street
Jackson, Mississippi 39201

WATER WELL DRILLERS LOG

July 18 1974 Chester Belver Lincoln
Date well completed firm name county well located

LANDOWNER: Stanley Lawrence RFD Ruth
(mailing address)

description of formations encountered	from	to
Red clay	0	22
Red sand	22	68
Sand & gravel	68	90
Chalk	90	102
Sand & gravel	102	115

WELL LOCATION:
sec. 36 T. 9 N. R. 9 E
4 miles SE of Ruth
(distance) (direction) (nearest town)

WELL PURPOSE: Home
(home, irrigation, municipal, industrial)

- WELL COMPLETION DATA:
- (1) diameter (inches) 4"
 - (2) total depth (feet) 115
 - (3) static water level (feet) 86 below top of ground.
 - (4) casing Plast Ballou
(material) (depth)
 - (5) screen 6' 109
(length) (depth to top)
 - 4" Plast
(size) (material)
 - (6) pump Byadant
(type power)
 - (7) electric log NO
(yes or no)
 - (organization running log)
 - (8) how well bottom plugged wooden plug


DRILLERS REMARKS: New location

DECEMBER 1974

OCT 31 1974

If well telescopes please sketch and show depths.

GROUND LEVEL

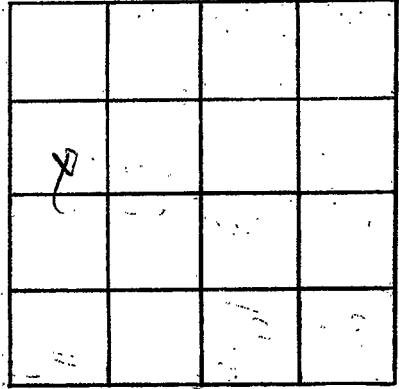

SECTION 36

Please indicate well location X.

ADDITIONAL INFORMATION

If more than one screen, show locations of each on sketch.