

LINCOLN
R24
6/6/80

MISSISSIPPI
BOARD OF WATER COMMISSIONERS
416 North State Street
Jackson, Mississippi 39201

CODEC

WATER WELL DRILLERS LOG

6-6-80 *Oriner Drilling Lincoln*
date well completed firm name county well located

LANDOWNER:
Amoco Production
Route 1, Box 181
Crosby, MS 39633
(mailing address)

description of formations encountered	from	to
<i>clay, sand, & rocks</i>	<i>0</i>	<i>119</i>
<i>sand + gravel</i>	<i>119</i>	<i>224</i>
<i>clay</i>	<i>224</i>	<i>287</i>
<i>sand</i>	<i>287</i>	<i>371</i>
<i>clay</i>	<i>371</i>	<i>602</i>

WELL LOCATION: *1700' N + 1668' W*
no. 24 T. 5 N R. 9 E of
John's *W 58/100*
Patrick *W 58/100*
and *W 58/100*
24-10 miles *East* of *Ruth*
(distance) (direction) (nearest town)

WELL PURPOSE: *oil field supply*
(home, irrigation, municipal, industrial)


- WELL COMPLETION DATA:
- (1) diameter (inches) *3"*
 - (2) total depth (feet) *602'*
 - (3) static water level (feet) *150'* ^{below} top of ground.
 - (4) casing *steel*, *357'*
(material) (depth)
3"
(size) if telescope see back.
 - (5) screen *42'*, *315'*
(length) (depth to top)
3", *perforated*
(size) (material)
 - (6) pump *70*
(HP) (yield gpm)
AC
(type power)
 - (7) electric log *—*
(yes or no)
—
(organization running log)
 - (8) how well bottom plugged *orange*
peel

DRILLERS REMARKS:

DEPT. OF NATURAL RESOURCES
BUREAU OF LAND & WATER RESOURCES
JUN 25 1980
RECEIVED

If well telescopes please sketch and show depths.

GROUND LEVEL

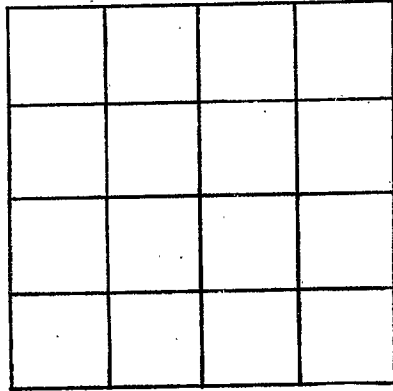

SECTION _____

Please indicate well location X.

ADDITIONAL INFORMATION

If more than one screen, show locations of each on sketch.