

MISSISSIPPI DEPARTMENT OF NATURAL RESOURCES

Bureau of Land and Water Resources

Southport Mall

P.O. Box 10631

Jackson, Mississippi 39209

WATER WELL DRILLERS LOG

CODED

Lincoln
R 25
4-16-81

AA Griner Drilling Service, Inc.


Lincoln

date well completed

firm name


county well located

LANDOWNER:	description of formations encountered	from	to
<u>Mobil Exploration Company</u> <u>P.O. Box 2252</u> <u>HOUSTON, TX. 77001</u> (mailing address)	<u>sand, pea gravel</u> <u>clay</u>	<u>0</u> <u>252</u>	<u>252</u> <u>273</u>
<p>WELL LOCATION: <u>2415'S + 935'W</u></p> <p><u>NO 1</u> sec. <u>10</u> T. <u>5(N)</u> R. <u>9(E)</u> OF <u>NEICO</u></p> <p><u>I.O. K222</u> <u>Ruth</u> miles of _____ of _____ (nearest town)</p>			
<p>WELL PURPOSE: <u>oil field</u> (home, irrigation, municipal, industrial) <u>supply</u></p>			
WELL COMPLETION DATA:			
(1) diameter (inches) <u>4"</u>			
(2) total depth (feet) <u>273'</u>			
(3) static water level (feet) <u>70'</u> <u>below</u> top of ground.			
(4) casing <u>steel</u> , <u>252'</u> (material) (depth)			
<u>4"</u> (size) if telescope see back.			
(5) screen <u>42'</u> , <u>231'</u> (length) (depth, to top)			
<u>4"</u> (size) <u>perforated</u> (material)			
(6) pump <u>—</u> , <u>70</u> (HP) (yield gpm)			
<u>AC</u> (type power)			
(7) electric log _____ (yes or no)			
_____ (organization running log)			
(8) how well bottom plugged <u>orange</u> <u>peel</u>			
DRILLERS REMARKS:			

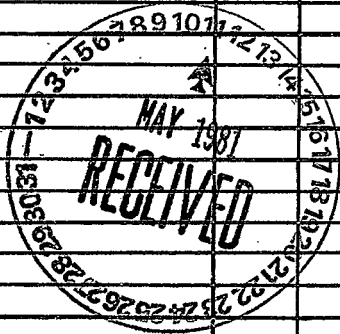

If well telescopes please sketch and show depths.

GROUND LEVEL

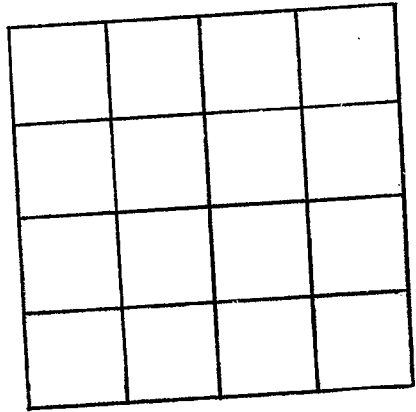

SECTION _____

Please indicate well location X.

ADDITIONAL INFORMATION

If more than one screen,
show locations of each on sketch.