

MISSISSIPPI DEPARTMENT OF NATURAL RESOURCES

Bureau of Land and Water Resources

Southport Mall

P.O. Box 10631

Jackson, Mississippi 39209

CODED

WATER WELL DRILLERS LOG

Lincoln
R 28

Nov 19-86 19 1986 Jeffrey Wells Tril
 date well completed firm name county well located

LANDOWNER:	description of formations encountered	from	to
<u>New Hope church -</u>			
<u>R.R. Ruth, Jr.</u> (mailing address)	<u>Red clay</u>	<u>0</u>	<u>20</u>
	<u>Red sand</u>	<u>20</u>	<u>97</u>
	<u>Coarse sand gravel</u>	<u>97</u>	<u>112</u>
WELL LOCATION:			
sec. <u>35</u> T. <u>5N</u> S. R. <u>9E</u> W			
<u>3</u> miles <u>SE</u> of <u>Ruth</u>			
(distance) (direction) (nearest town)			
WELL PURPOSE: <u>CHURCH</u> (home, irrigation, municipal, industrial)			
WELL COMPLETION DATA:			
(1) diameter (inches) <u>4</u>			
(2) total depth (feet) <u>112</u>			
(3) static water level (feet) <u>75</u> below top of ground.			
(4) casing <u>PVC</u> , <u>102</u> (material) (depth)			
<u>4</u> (size) if telescope see back.			
(5) screen <u>10</u> , <u>102</u> (length) (depth to top)			
<u>4</u> , <u>PVC</u> (size) (material)			
(6) pump <u>1/2</u> , <u>10</u> (HP) (yield gpm)			
<u>el</u> (type power)			
(7) electric log <u>no</u> (yes or no)			
(organization running log)			
(8) how well bottom plugged <u>and plug</u>			
DRILLERS REMARKS:			

CODED


RECEIVED

DEC 22 1986

Department of Natural Resources
Bureau of Land & Water Resources

If well telescopes please sketch and show depths.

GROUND LEVEL

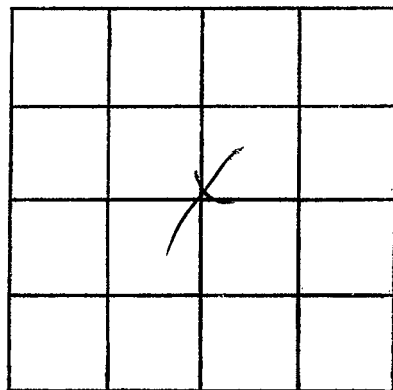

SECTION 35

Please indicate well location X.

ADDITIONAL INFORMATION

If more than one screen,
show locations of each on sketch.