	C IVI II Dement		
	State Well Report	For Office Use Only:	
County: Lincoln	Part 1 Mississippi Department of Environmental Quali	ty Aquifer: <u><b>2</b>59</u>	
Permit #:	Office of Land and Water Resources	Well #:	
Driller:	P.O. Box 10631	L. S. Elevation:	
SUPPLY, INC. /10	Jackson, MS 39289-0631 (601)961-5210		
Date drilling completed:	(601)354-6938 (fax)	E-log #:	
	-	d with the Department within	
State Law requires that this rep 30 days of completion of drillin	port be prepared by the driller in detail and file		
30 days of completion of drinn Well Owner Inform	ation	Well Location GO	
Owner Name James Holmes	Latitude: 31 • 24.	Latitude: 31 . 24. 884" Longitude: 96 . 17 . 846"	
Mailing Address: 2776 Hol	mes Ln Method of Lat/Long (circ	cle one): Conventional Survey,	
		-held GPS, Survey-grade GPS	
Ruth ms	<u>39662</u> <u>NE 14 SE</u> 14 Sec_ tate Zip Code	9	
Telephone No. (601) 833 - 111	Distance Directi	ion Nearest, Town of Brockhavey	
Telephone No. ( <u>601) 032 110</u>		,	
	Well Data		
Purpose of Well (circle one) Home I	ndustrial Public Supply Irrigation Fish Cultur	re Other:	
Date well drilling started:10/6	Date well drilling completed:	10/7/10	
If flowing method of flow regulation: V	Valve Other (describe)		
	above or below (circle one) land surface Date measure	ured: 10/7/10	
Method of Measurement (circle one)			
Hole depth: 19 Well of	depth: <u>114</u> Well grouted to a depth	n of <u>10</u> feet	
Type of grout (circle one): Cement	Bentonite Mix	0	
Quint 104 for Cr	asing diameter: inches Type of casi	ing: PVC	
Casing length: <u>10</u> feet Su	creen diameter: <u>4</u> inches Type of scre	en: PVL	
Screen slot size: ()1/) inche	s Setting depth: From 104 feet to	114feet	
Type of completion (circle all applicable	e): Gravel packed Underreamed Telescoped	Open hole Natural Development	
	Other (describe):		
Top of lap pipe or reduction in casing:	feet. If telescoped or more than o		
	nun Electric Gamma Ray Density Sonic Neut		
-			
Name of organization running log(s): I certify that the well was drilled, con	structed, and completed in accordance with all appl	icable requirements of the Mississippi	
Department of Environmental Qualit	y and/or the Mississippi Department of Health regu	lations and state laws.	
	PLY, INC.		
GRENN WATER WELL & SUPP			
GRENN WATER WELL & SUPP WILLIAM L. HARDIN, LIC.	NO. 0-802 Chun	Hardm	

. •


## If well telescopes please sketch below and show depths.



· •:

:1	Description of Formations Encountered	From	
	Citropelle (lay Sand W/ Clay Streaks 1000+@ Clay White Clay	0 17 el 70 114 \$	

If more than one screen, show location of each on sketch

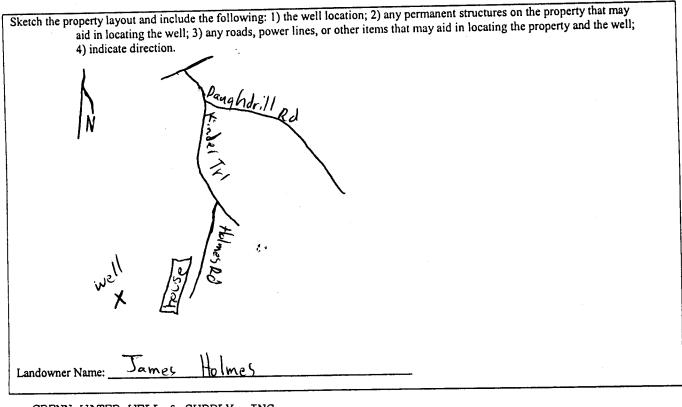

GRENN WATER WELL & SUPPLY, INC. WILLIAM L. HARDIN, LIC. NO. 0-802

Hardm n

Signature of Water Well Contractor

	Part 2	For Office Use Only:	
	"s Completion Report ent of Environmental Quality	Aquifer:	
Permit #: Office of Land	and Water Resources		
Driller OKENN WATER WELL &	. Box 10631 MS 39289-0631	Well #:	
	1)961-5210 154-6938 (fax)	Elevation:	
This report should be prepared by the pump installer in det installation of pump.	tail and filed with the Departm	ent within 30 days of the	
Well Owner Information		Il Location	
Owner Name: James Holmes	Latitude: 31° 2 4 884 N Longitude: 90° 17 8 46 W		
Mailing Address: 2776 Holmes Ln	Method of Lat/Long (circle one): Conventional Survey,		
	USGS quad, Han	USGS quad, Hand-held GPS, Survey-grade GPS	
Ruth ms 39662- City State Zip Code	<u>NE 1/2 SE 1/2 Sec 9 Twn 5N Rng 9E</u>		
City State Zip Code	Distance Direction	Nearest Town	
Telephone No. (601) 833 1169	9 Miles SE of Brookhaven		
Pump Type Circle one	Power Type Circle one		
Air Lift Jet Submersible		ne Engine Natural Gas	
Bucket Piston Turbine	Electric Motor Hand	5	
Centrifugal Rotary Flowing Well		(specify):	
Other (specify):		r:	
Date Pump Installed: 10/7/10	Setting Depth: 110		
Rated Pump Capacity: 6Gallons Per Minute	Number of Stages:	······································	
Pump Test Data		easuring Water Level	
Date Well Tested: 10 / 7 / 10		Circle one	
Static Water Level (A): 73 Feet Below Land Surface		asuring Line Steel Tape	
Pumping Water Level (B): 79 Feet Below Land Surface	Other (specify):		
Drawdown [(B) – (A)]: 6 Feet Below Land Surface	For flowing well, measured s	hut in head:feet	
Test Pumping Rate: 18Gallons Per Minute		GPM with a drawdown of	
Duration of Pump Test (minimum 4 hours): hours	feet after	hours of pumping	
I HEREBY CERTIFY that the above statements are true to the best GRENN WATER WELL & SUPPLY, INC.	of my knowledge.	、	
WILLIAM L. HARDIN, LIC. NO. 0-802 Print Name of Pump Installer and License No. (if applicable)	Signature of Pump I	mstaller	
	Signature of Lump I		

5

OCT 1 8 2010

BADING

. **.**