	State Well Rep	port	
County: hice/n	Part 1 – Driller's Log		For Office Use Only:
Permit #:	Mississippi Department of Envir Office of Land and Water		Aquifer: <u>F62</u>
Driller: Fitzcerald Well Sere	P.O. Box 2309		Well #:
• • •	Jackson, MS 392 (601)961- 5210		L. S. Elevation:
Date drilling completed: 12-27-10.	(601)961- 5228 (f		
State Law requires that this repor			
Department at the above address Information on Well O			or borehole. rehole Location
(Landowner if borehole is not fo			Longitude: 90° 19, 0.3
Owner Name Todd Bouigeos.			Longitude: 10 19,00
Mailing Address: Hwy 570	Method of	of Lat/Long (circle or	e): Conventional Survey,
Maning Address. 199	US	GS quad, Hand-held	GPS, Survey-grade GPS
	Atri	5% 1/4 Sec 29	TWN SN Rng 8E
Kuth ms		NE	
City Stat	e Zip Code Distance	Direction Miles	Nearest Town of
Telephone No. ()			
	Well / Borehole Data		
Date drilling started: 2-27-19Date dri	lling completed: 12-27-10 Hole	denth: 118'	Hole diameter:
		dopui. <u>110</u>	
Location of the source of any surface wate Method of dosing and volume of Chlorine			· · · · · · · · · · · · · · · · · · ·
Logs run (circle all applicable): No log run Name of organization running log(s):	Electric Gamma Ray Density	Sonic Neutron	Other:
	· ·		
Purpose of borehole (check one): Water We	ell Geotechnical/Geological Inve	stigation Ground	Source Heat Pump
	urvey Other (describe)		
	<u>to water well construction, skip the</u>		
Purpose of Well (check one): Home	dustrial Public Supply Irrigat	ion Fish Culture _	Other:
If a flowing well, method of flow regulation	n: Valve Other (descr	ibe)	
Static Water Level: feet ab	ove or below (circle one) land surface	Date measured:	12-27-10,
	\sim		
	electric tape air lin	-	~
Well depth: <u>II</u> Well grouted to a dep		ircle one). Neat Cem	ent Bentonite Mix
Casing length: 108 feet Casin	g diameter: <u> </u>	Type of casing:	ve
Screen length: <u>10</u> feet Scree	n diameter: <u>4"</u> inches		•
Screen slot size:iOl2inches	Setting depth: From	feet tofeet_to	feet
Type of completion (circle all applicable):	Stavel packed Underreamed	Telescoped Open	hole Natural Development
			
	Other (describe):		
Top of lap pipe or reduction in casing:			en, describe on next page
			en, describe on next page Form: OLWR-SWR-1A (04)
			Form: OLWR-SWR-1A (04

R62

The sketch below only required for water wells


a 🐔 🖉 🤘

Description of formations encountered must be provided for all wells and boreholes, unless specifically exempted by regulations

If well telescopes, show depths on sketch. Ground Level.

Description of Formations Encountered		To (depth)
	Ground Level	
Clwy,	0	20
Clutter,	20	40
Sech de	40	60
c/we-	60	10
elute	80	69
Sand,	90	100
Course sanci	100	118
		ļ
		ļ
	<u> </u>	_
		ļ
		
	+	
		·
		4
	+	
	+	
	+	.
	+	· · · · · · · · · · · · · · · · · · ·
	+	+
	1	1

If more than one screen, show location of each on sketch

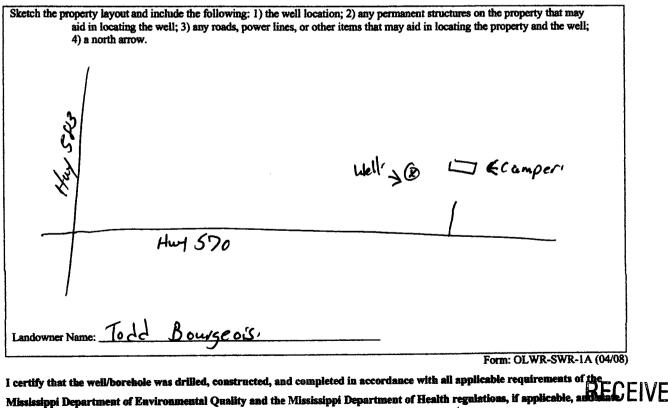

laws Bul Sy

12-27-10 d Ptran Date

Print Name of Responsible Licensee and License No.

Signature of Licensee

JAN 1 9 2011 BY: OLWB

County: Licolo Permit #: Miss Driller: F.fzgeath Well Sece, Date completed: 12-2710, <u>Copy information from block on Part 1</u>	For Office Use Only: Part 2 Pump Installer's Completion Report Signification Report Office Use Only: Aquifer: Well #: Elevation: Distaller. A copy of Part 1 of the Need water well contractor or a licensed pump installer. A copy of Part 1 of the
report must be attached and both parts filed with	he Department at the above address within 30 days of well completion. Well Location
Well Owner Information	
Dwner Name: <u>TJdd Bourgeos</u> , Mailing Address: <u>Huy 570</u>	Latitude: 1 1 1 Longitude: 00 1 1 0 00
Viailing Address: Huy 570	Method of Lat/Long (check one): Conventional Survey,
*	USGS and Hand-held GPS Survey-grade GPS
<u>kuth</u> ms, City State	<u> </u>
City State	Lip Code Direction Nearest Town
Telephone No. ()	Distance
Pump Type	Power Type Circle one
Circle one Air Lift Jet Subr	Diesel Engine Gasoline Engine Natural Gas
Bucket Piston Turb	he Hectric Motor Hand Tractor PTO
Centrifugal Rotary Flow	ng Well Windmill Other (specify):
Other (specify):	Horse Power Rating of Motor:
	C. /
Date Pump Installed: <u>12-27-10</u> ,	~
Rated Pump Capacity:Gallo	s Per Minute Number of Stages:
	Method of Measuring Water Level
Pump Test Data Date Well Tested:	Circle one
Static Water Level (A):Feet Below	Air Line Electric Measuring Line
	Other (specify).
Pumping Water Level (B):Feet Below	fact to the fact
Drawdown [(B) - (A)]:Feet Below	Land Surface For flowing well, measured shut in head:feet
Test Pumping Rate:Galle	as Per Minute Well yieldedGPM with a drawdown of
Duration of Pump Test (minimum 4 hours):	hours of numping
This is for (circle one): New Well	Replacement of Existing Pump Repair of Existing Pump
I HEREBY CERTIFY that the above statements BIAL Flageard, Oc	4 Beel Surger Signature of Pump Installer
Print Name of Pump Installer and License No. (Form: OLWR-SWR-16 (07

аран тар тар тар

BY: OLWR