
	State W	ell Report	To Office Hee Only		
County: Lincoln	,	art 1	For Office Use Only:		
County: L. M. Co. W.	Mississippi Department of Environmental Quality		Aquifer:		
Permit #:	1	nd Water Resources	Well #:		
Driller: GRENN WATER WELL	•	ox 10631			
& SUPPLY, INC. Date drilling completed: 5-29-/2	•	S 39289-0631	L. S. Elevation:		
Date drilling completed:		961-5210 I-6938 (fax)	E-log #:		
·] (001)55	i-0550 (Mil)			
State Law requires that this report be prepared by the driller in detail and filed with the Department within 30 days of completion of drilling of the well.					
Well Owner Inform		Wel	Location		
Owner Name Wayne Nations		Latitude: 31° 23;71	2" Longitude: 90 19:119 "		
Mailing Address: 3220 Topisew Ch. Dv		Method of Lat/Long (circle or	ne): Conventional Survey,		
			GPS, Survey-grade GPS		
Ruth, Ma	39662 ate Zip Code	<u>SW4 SE4</u> Sec 17	Twn SN Rng JE		
5		Distance Direction	Nearest Town		
Telephone No. (601) 757-30	27	Miles	of Ruth		
· · · · · · · · · · · · · · · · · · ·	Well I	Data			
Purpose of Well (circle one) Home Industrial Public Supply Irrigation Fish Culture Other:					
Date well drilling started: 5-25-/2 Date well drilling completed: 5-29-/2					
If flowing, method of flow regulation: Va	alve Other (d	escribe)			
Static Water Level: 74 feet above on below circle one) land surface Date measured: 5-29-12					
Method of Measurement (circle one) steel tape electric tape air line other:					
Hole depth: 97 Well de		Well grouted to a depth of _	feet		
Type of grout (circle one): Cement Bentonite Mix					
Casing length: 85 feet Casing diameter: 4 inches Type of casing: PVC					
Screen length: 10 feet Screen diameter: 1 inches Type of screen: PVC					
Screen slot size: 4010 inches Setting depth: From \$5 feet to 95 feet					
Type of completion (circle all applicable): Gravel packed Underreamed Telescoped Open hole Natural Development					
Other (describe):					
Top of lap pipe or reduction in casing:feet. If telescoped or more than one screen, describe on back of page					
Logs run (circle all applicable): No log run Electric Gamma Ray Density Sonic Neutron Other:					
Name of organization running log(s):	·				
I certify that the well was drilled, const	-	= =			
Department of Environmental Quality and/or the Mississippi Department of Health regulations and state laws.					
GRENN WATER WELL & SUPP WILLIAM L. HARDIN V, U		Cha 7	Fordin		
Print Name of Water Well Contractor and	l License No.	Signature of	f Water Well Contracted FCFIVFI		
			I I WILLIA C.		

If well telescopes please sketch below and show depths.

Ground Level

Description of Formations Encountered	From	To
Description of Formations Encountered	0	10
Streeky		-
SCIECK	10	3 0
Sand	30	25
sendtgravel	85	77
	-	
	+	
	_	
		-
	-	

If more than one screen, show location of each on sketch

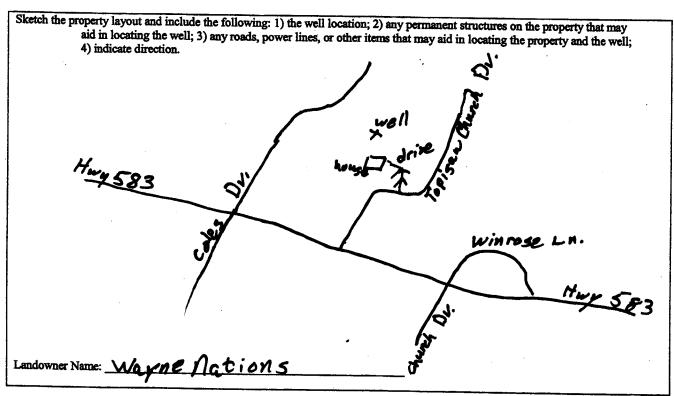

Signature of Water Well Contractor

STATE WELL REPORT Part 2

County: Lincoln Driller: GRENN WATER WELL

Permit #:

Pump Installer's Completion Report Mississippi Department of Environmental Quality Office of Land and Water Resources P.O. Box 10631 Jackson, MS 39289-0631 (601)961-5210

For Office Use Only:			
Aquifer:			
Well #:	R-70		
Elevation:			

This report should be prepared by the pump installer in detail and filed with the Department within 30 days of the installation of pump. Well Owner Information Owner Name: Wayne Nations Well Location Owner Name: Wayne Nations Owner Information Owner Name: Wall Location Latitude: 31°23°712 Longitude: 70°19′118′ Method of Lat/Long (circle one): Conventional Survey, USGS quad, dand-held GPS) Survey-grade GPS Sw. 1/2 1/2 Sec. 17 Twn. Sw. Rng 1/2 Distance Direction Nearest Town I Miles Nof Ruth Power Type Circle one Air Lift Jet Submersible Diesel Engine Gasoline Engine Natural Gas Bucket Piston Turbine Electric Motor Hand Tractor PTO Centrifugal Rotary Flowing Well Windmill Other (specify): Other (specify): Horse Power Rating of Motor: 1/2 Date Pump Installed: 5/30/12 Setting Depth: 94 feet Number of Stages: 9
Well Owner Information Owner Name: \(\lambda \) \(\lamb
Mailing Address: 3220 Top you Ch. Dr. Wethod of Lat/Long (circle one): Conventional Survey, USGS quad, Mand-held GPS) Survey-grade GPS St. 4.5£ 4.5 Sec. 17 Twn S. M. Rng City State Zip Code Distance Direction Nearest Town L. Miles N. of R. L. H. Pump Type Circle one Air Lift Jet Submersible Bucket Piston Turbine Centrifugal Rotary Flowing Well Other (specify): Date Pump Installed: 5/30/12 Bated Pump Capacity: 10 Gallons Per Minute Method of Lat/Long (circle one): Conventional Survey, Winds J. S. W. 4.5£ 4.5 Sec. 17 Twn S. M. Rng St. W. 4.5£ 4.5 Sec. 17 Twn S. M. Rng Distance Direction Nearest Town Distance Direction Nearest Town Under St. W. 4.5£ 4.5 Sec. 17 Twn S. M. Rng St. W. 4.5£ 4.5 Sec. 17 Twn S. M. Rng St. W. 4.5£ 4.5 Sec. 17 Twn S. M. Rng St. W. 4.5£ 4.5 Sec. 17 Twn S. M. Rng St. W. 4.5£ 4.5 Sec
USGS quad, ctand-held GPS Survey-grade GPS
City State Zip Code City State Zip Code Distance Direction Nearest Town QE
Telephone No. (60 l) 757 ~ 3077 Pump Type Circle one Air Lift Jet Submersible Diesel Engine Gasoline Engine Natural Gas Bucket Piston Turbine Electric Motor Hand Tractor PTO Centrifugal Rotary Flowing Well Windmill Other (specify): Horse Power Type Circle one Natural Gas Setting Depth: 94 feet Rated Pump Capacity: 10 Gallons Per Minute Number of Stages: 9
Telephone No. (60 l) 757 ~ 3077 Pump Type Circle one Air Lift Jet Submersible Diesel Engine Gasoline Engine Natural Gas Bucket Piston Turbine Electric Motor Hand Tractor PTO Centrifugal Rotary Flowing Well Windmill Other (specify): Horse Power Type Circle one Natural Gas Setting of Motor: Date Pump Installed: 5/30/12 Setting Depth: 94 feet Number of Stages: 9
Pump Type Circle one Air Lift Jet Submersible Diesel Engine Gasoline Engine Natural Gas Bucket Piston Turbine Electric Motor Hand Tractor PTO Centrifugal Rotary Flowing Well Windmill Other (specify): Horse Power Rating of Motor: Date Pump Installed: Setting Depth: Quantify Feet Number of Stages: Number of Stages:
Circle one Air Lift Jet Submersible Diesel Engine Gasoline Engine Natural Gas Bucket Piston Turbine Electric Motor Hand Tractor PTO Centrifugal Rotary Flowing Well Windmill Other (specify): Horse Power Rating of Motor: Date Pump Installed: 5/30/12 Setting Depth: 94 feet Rated Pump Capacity: Number of Stages: 9
Circle one Air Lift Jet Submersible Diesel Engine Gasoline Engine Natural Gas Bucket Piston Turbine Electric Motor Hand Tractor PTO Centrifugal Rotary Flowing Well Windmill Other (specify): Horse Power Rating of Motor: Date Pump Installed: 5/30/12 Setting Depth: 94 feet Rated Pump Capacity: Number of Stages: 9
Bucket Piston Turbine Blectric Motor Hand Tractor PTO Centrifugal Rotary Flowing Well Windmill Other (specify): Other (specify): Date Pump Installed: 5/30/12_ Setting Depth: 94
Centrifugal Rotary Flowing Well Windmill Other (specify): Other (specify): Horse Power Rating of Motor: Date Pump Installed: 5 / 3 0 / 1 2
Other (specify): Horse Power Rating of Motor: Date Pump Installed: 5/30/12
Date Pump Installed: 5/30/12 Setting Depth: 94 feet Rated Pump Capacity: 10 Gallons Per Minute Number of Stages: 9
Rated Pump Capacity: 16 Gallons Per Minute Number of Stages: 9
Pump Test Data Method of Measuring Water Level
Date Well Tested: 5/30/12
Static Water Level (A): 74 Feet Below Land Surface Air Line Electric Measuring Line Steel Tape
Pumping Water Level (B): 77 Feet Below Land Surface Other (specify):
Drawdown [(B) - (A)]: Feet Below Land Surface For flowing well, measured shut in head: feet
Test Pumping Rate: 14 Gallons Per Minute Well yielded 14 GPM with a drawdown of
Duration of Pump Test (minimum 4 hours): 4 hours 3 feet after 4 hours of ramping
Duration of Pump Test (minimum 4 hours): 4 hours feet after 4 hours of pumping
I HEREBY CERTIFY that the above statements are true to the best of my knowledge.

I HEREBY CERTIFY that the above statements are true to the best of	of my knowledge.
WILLIAM L. HARDIN, V, UNR-00000802	Clos (william) Hardy
Print Name of Pump Installer and License No. (if applicable)	Signature of Pump Installer

RECEIVE