

Lincoln
 R 2000
 8-10-76

MISSISSIPPI
 BOARD OF WATER COMMISSIONERS
 416 North State Street
 1374 Jackson, Mississippi 39201

WATER WELL DRILLERS LOG

8-10

19

76 Fitzgualdell Law

Lincoln

date well completed

firm name

county well located

LANDOWNER:

Bobby Owens -

R.R. Ruth Min.
 (mailing address)

description of formations encountered

from

to

Red clay	0	20
hard sand	20	50
Coarse sand & gravel	50	76

WELL LOCATION:

sec. 34 T. 5 N R. 9 E
 S W
 4 miles SE of Ruth
 (distance) (direction) (nearest town)

WELL PURPOSE:

(home, irrigation, municipal, industrial)

WELL COMPLETION DATA:

- (1) diameter (inches) 4
- (2) total depth (feet) 76
- (3) static water level (feet) 25 below above top of ground.
- (4) casing PVC, 68 (material) (depth)
 4 (size) If telescope see back.
- (5) screen 8' PVC, 18 (length) (depth to top)
 4 (size) (material)
- (6) pump 1/2 (HP) 10 (yield gpm)
 elec (type power)
- (7) electric log No (yes or no)

(organization running log)

- (8) how well bottom plugged Sanded


RECEIVED

AUG 20 1976

DRILLERS REMARKS:

If well telescopes please sketch and show depths.

GROUND LEVEL

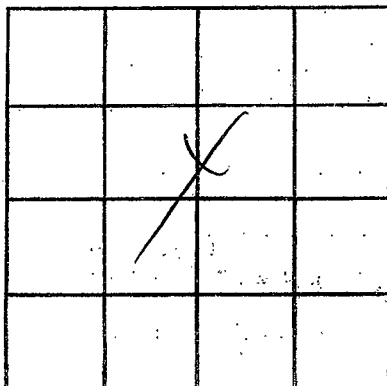

SECTION 34

Please indicate well location X.

ADDITIONAL INFORMATION

If more than one screen, show locations of each on sketch.