

Lincoln
R 2001
2-16-77

MISSISSIPPI
BOARD OF WATER COMMISSIONERS
416 North State Street
Jackson, Mississippi 39201

WATER WELL DRILLERS LOG

2-16 1977 *Fitzgerald Well Serv* Lincoln
date well completed firm name county well located

LANDOWNER:

Lopisaw Lodge

R.R. Ruth Miss.
(mailing address)

WELL LOCATION:

sec. 5 T. 5 N. R. 9 E.
3 miles NE of Ruth
(distance) (direction) (nearest town)

WELL PURPOSE: Home
(home, irrigation, municipal, industrial)

WELL COMPLETION DATA:

- (1) diameter (inches) 4"
- (2) total depth (feet) 74
- (3) static water level (feet) 32 below above top of ground.
- (4) casing BVC 66
(material) (depth)
4 If telescope see back.
(size)
- (5) screen 8 66
(length) (depth to top)
4 PVC
(size) (material)
- (6) pump 1/2 10
(HP) (yield gpm)
Electric
(type power)
- (7) electric log no
(yes or no)
(organization running log)
- (8) how well bottom plugged sealed off

description of formations encountered

from to

<i>Red clay</i>	<i>0</i>	<i>20</i>
<i>Red sand</i>	<i>20</i>	<i>60</i>
<i>Coarse silt gravel</i>	<i>60</i>	<i>74</i>


DRILLERS REMARKS:

RECEIVED
MAR 8 '77

MISS. DE. OF WATER COMMISSIONERS

If well telescopes please sketch and show depths.

GROUND LEVEL

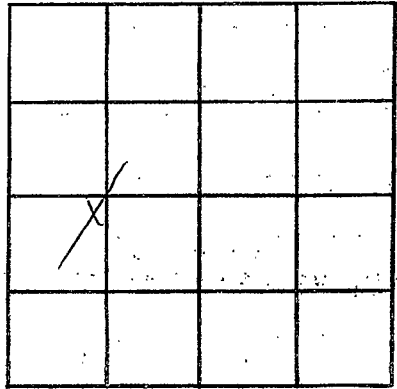

SECTION 5

Please indicate well location X.

ADDITIONAL INFORMATION

If more than one screen, show locations of each on sketch.