

Lincoln
R 2002
4-6-77

MISSISSIPPI
BOARD OF WATER COMMISSIONERS
416 North State Street
Jackson, Mississippi 39201

WATER WELL DRILLERS LOG

4-6
date well completed

1374

19 77 Fetzell Steel Serv
firm name

Lincoln
county well located

LANDOWNER:

Buster Freeman

R.B. James -
(mailing address)

WELL LOCATION:

sec. 35 T 50 N R 9 E
S W

3 miles S of Beth
(distance) (direction) (nearest town)

WELL PURPOSE:

Home
(home, irrigation, municipal, industrial)

WELL COMPLETION DATA:

- (1) diameter (inches) 4
- (2) total depth (feet) 140
- (3) static water level (feet) 100 below above top of ground.
- (4) casing PVC, 1.32, (material) (depth)
4 (size) if telescope see back.
- (5) screen 8, 1.32 (length) (depth to top)
4 (size) PVC (material)
- (6) pump 1/2, 10 (HP) (yield gpm)
elec (type power)
- (7) electric log no (yes or no)
(organization running log)
- (8) how well bottom plugged Seal block

description of formations encountered

from to

Red clay	0	20
Red sand	20	100
Red clay	100	130
Coarse sand & gravel	130	140

DRILLERS REMARKS:


RECEIVED

JUL 5 - 1977

MISS. Bd. OF WATER COMMISSIONERS

If well telescopes please sketch and show depths.

GROUND LEVEL

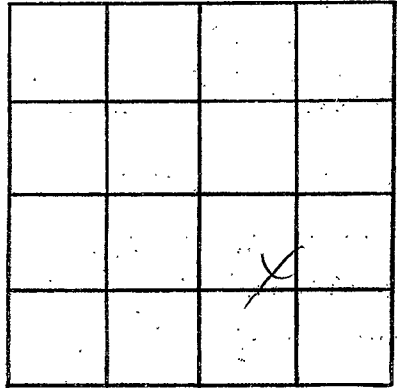

SECTION 35

Please indicate well location X.

ADDITIONAL INFORMATION

If more than one screen, show locations of each on sketch.