

Lincoln
R 2004
6-9-77

(63)

MISSISSIPPI
BOARD OF WATER COMMISSIONERS
416 North State Street
134 Jackson, Mississippi 39201

WATER WELL DRILLERS LOG

June 9 1977 Russ Miller Lincoln
date well completed firm name county well located

LANDOWNER:	description of formations encountered	from	to
<p>Mr. Frank Green Rt. Ruth Miss (mailing address)</p>	<p>Clay fine red sand pink Chalk Sand</p>	<p>0</p>	<p>17 140 122 133</p>
<p>WELL LOCATION: sec. <u>3</u> T <u>5</u> N R <u>9</u> E <u>4 1/2</u> miles <u>north</u> of <u>Ruth</u> (distance) (direction) (nearest town)</p>			
<p>WELL PURPOSE: <u>home</u> (home, irrigation, municipal, industrial)</p>			
<p>WELL COMPLETION DATA:</p> <p>(1) diameter (inches) <u>4"</u></p> <p>(2) total depth (feet) <u>133</u></p> <p>(3) static water level (feet) <u>85</u> below top of ground.</p> <p>(4) casing <u>plastic bottom</u> (material) (depth)</p> <p><u>5</u> if telescope see back. (size)</p> <p>(5) screen <u>6"</u> <u>127</u> (length) (depth to top)</p> <p><u>4"</u> <u>plastic</u> (size) (material)</p> <p>(6) pump <u>3/4</u> <u>12</u> (HP) (yield gpm)</p> <p><u>split</u> (type power)</p> <p>(7) electric log <u>no</u> (yes or no)</p> <p>(organization running log)</p>			
<p>(8) how well bottom plugged <u>wooden plug</u></p> <p>DRILLERS REMARKS: <u>✓</u></p>			


RECEIVED

AUG 26 1977

MISS. Bd. OF WATER CONTROL

If well telescopes please sketch and show depths.

GROUND LEVEL

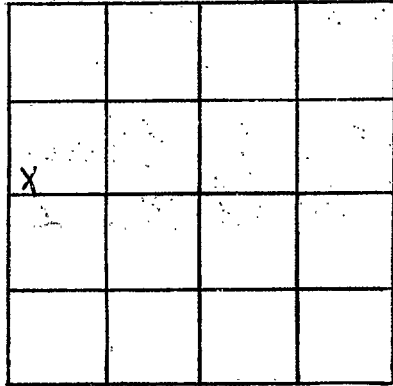

SECTION 3

Please indicate well location X.

ADDITIONAL INFORMATION

If more than one screen, show locations of each on sketch.