

Lincoln  
R 2005  
8/9/77

MISSISSIPPI  
BOARD OF WATER COMMISSIONERS  
416 North State Street  
Jackson, Mississippi 39201

102

WATER WELL DRILLERS LOG

Aug 9 1977 Reeves Miller Lincoln  
date well completed firm name county well located

LANDOWNER:  
Willie Jenkins  
Rt Ruth  
(mailing address)

description of formations encountered	from	to
<u>red clay</u>	<u>0</u>	<u>18</u>
<u>pink chert</u>	<u>18</u>	<u>30</u>
<u>sand &amp; gravel</u>	<u>30</u>	<u>62</u>
<u>cherty sand</u>	<u>62</u>	<u>93</u>
<u>coarse sand</u>	<u>93</u>	<u>117</u>

WELL LOCATION:  
sec. 32 T. 5 N. R. 9 E  
0.2 miles South of Ruth  
(distance) (direction) (nearest town)

WELL PURPOSE: home  
(home, irrigation, municipal, industrial)

WELL COMPLETION DATA:

(1) diameter (inches) 4"

(2) total depth (feet) 117'

(3) static water level (feet) 92' below above top of ground.

(4) casing plastic bottom  
(material) (depth)

       if telescope see back.  
(size)

(5) screen 5" 112'  
(length) (depth to top)

4" plastic  
(size) (material)

(6) pump 1/2 hp 10  
(HP) (yield gpm)

elec  
(type power)

electric log no  
(yes or no)

(8) no mization running log

no bottom plugged


DRILLERS RE: plug

RECEIVED  
DEC 30 1977

MISS. BD. OF WATER COMMISSIONERS

If well telescopes please sketch and show depths.

GROUND LEVEL

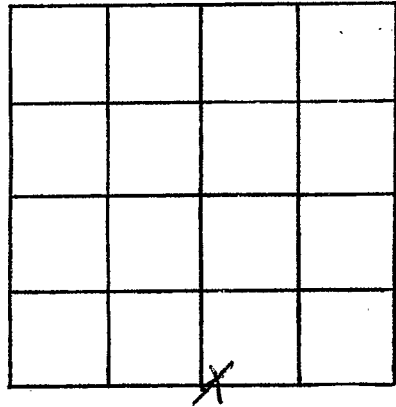

SECTION 32

Please indicate well location X.

ADDITIONAL INFORMATION

Lined area for additional information, consisting of approximately 20 horizontal lines. The bottom right corner of this area is torn.

If more than one screen, show locations of each on sketch.