

(146)

LINCOLN
R 2006
10/20/77

MISSISSIPPI
BOARD OF WATER COMMISSIONERS
416 North State Street
Jackson, Mississippi 39201

WATER WELL DRILLERS LOG

Lincoln
~~Waltham~~
county well located

10-20 1977 ~~Rever Well Co.~~
date well completed firm name

LANDOWNER:
Vinita Willson
Rt Ruth
(mailing address)

description of formations encountered	from	to
Clay	0	12
Red Sand	12	90
Sand Gravel	90	110

WELL LOCATION:
sec. 29 T 5 N R 9 E
1 miles South of Ruth
(distance) (direction) (nearest town)

WELL PURPOSE: Home
(home, irrigation, municipal, industrial)


- WELL COMPLETION DATA:
- (1) diameter (inches) 4"
 - (2) total depth (feet) 110"
 - (3) static water level (feet) 90 below
top of ground. above
 - (4) casing plastic bottom
(material) (depth)
 - (size) If telescope see back.
 - (5) screen 3' 105"
(length) (depth to top)
 - 4" plastic
(size) (material)
 - (6) pump 1/2 HP 10
(HP) (yield gpm)
 - 1/2 HP
(type power)
 - (7) electric log no
(yes or no)

Organization running log
Bottom plugged plug

RECEIVED
FEB 27 1978

If well telescopes please sketch and show depths.

GROUND LEVEL

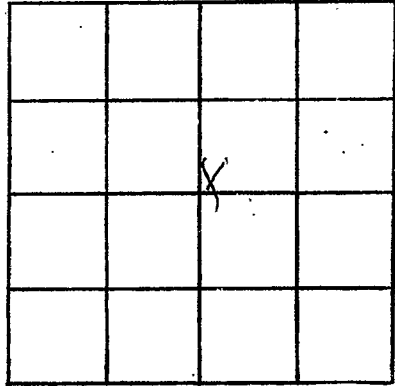

SECTION 29

Please indicate well location X.

ADDITIONAL INFORMATION

If more than one screen,
show locations of each on sketch.