

Lincoln  
R 2007  
12/17/77

MISSISSIPPI  
BOARD OF WATER COMMISSIONERS  
416 North State Street  
Jackson, Mississippi 39201

WATER WELL DRILLERS LOG

17 Dec 1977 date well completed  
1322 Amo Paper Well Co. firm name  
Lincoln county well located

LANDOWNER:  
Hall's Edwards  
  
(mailing address)

WELL LOCATION:  
sec 31 T 5 N R 9 E  
3 miles N of Faldsboro  
(distance) (direction) (nearest town)

WELL PURPOSE:  
(home, irrigation, municipal, industrial)

- WELL COMPLETION DATA:
- (1) diameter (inches) 4
  - (2) total depth (feet) 91
  - (3) static water level (feet) 70 above top of ground
  - (4) casing 41 (material) 85 (depth)  
(size) if telescope see back.
  - (5) screen 6 (length) 85 (depth to top)  
(size) (material)
  - (6) pump 1/2 (HP) 20 (yield gpm)  
(type power)
  - (7) electric log (yes or no)
  - (organization running log)
  - (8) how well bottom plugged used

description of formations encountered	from	to
clay	0	25
bedded chka	25	45
chka	45	60
2nd	60	91


DRILLERS REMARKS:

RECEIVED  
FEB 14 1977

MISS. Bd. OF WATER COMMISSIONERS

If well telescopes please sketch and show depths.

GROUND LEVEL

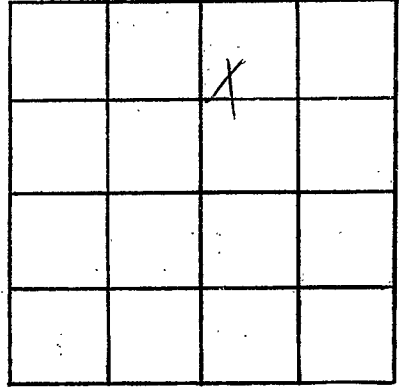

SECTION 31

Please indicate well location X.

ADDITIONAL INFORMATION

If more than one screen, show locations of each on sketch.