

LINCOLN
R 2008
2/13/78

MISSISSIPPI
BOARD OF WATER COMMISSIONERS
416 North State Street
Jackson, Mississippi 39201

WATER WELL DRILLERS LOG

Feb. 13 19 78 Grenn Water Well Cont. Lincoln
date well completed firm name county well located

LANDOWNER: Ray Davis
Ruth, Miss. 39682

(mailing address)

description of formations encountered	from	to
Clay	1	20
sand & gravel	20	78
white clay	78	90
blue clay	90	100
sand	100	152

WELL LOCATION:
sec. 24 T 5 N R 9 E
-S- W-
13 miles ?SE of Bogue Chitto
(distance) (direction) (nearest town)

WELL PURPOSE: home
(home, irrigation, municipal, industrial)

WELL COMPLETION DATA:

(1) diameter (inches) 6

(2) total depth (feet) 152

(3) static water level (feet) 70 below top of ground.

(4) casing PVC 140
(material) (depth)
4" if telescope see back.
(size)

(5) screen 12' 140'
(length) (depth to top)
.010 PVC
(size) (material)

(6) pump did not install
(HP) (yield gpm)

(type power)

(7) electric log no
(yes or no)

(organization running log)

(8) how well bottom plugged
backwash valve


DRILLERS REMARKS:

RECEIVED
FEB 27 1978

MISS. BD. OF WATER COMMISSIONERS

If well telescopes please sketch and show depths.

GROUND LEVEL

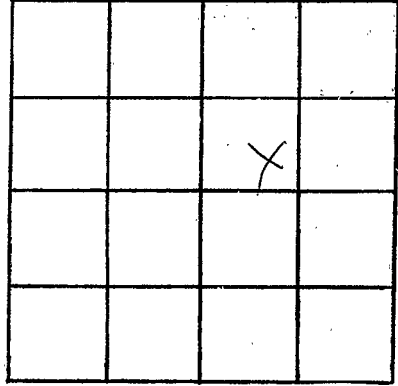

SECTION 24

Please indicate well location X.

ADDITIONAL INFORMATION

If more than one screen, show locations of each on sketch.