

LINCOLN

R 2010

5-16-78

MISSISSIPPI BOARD OF WATER COMMISSIONERS
416 North State Street
Jackson, Mississippi 39201

WATER WELL DRILLERS LOG

5-16 date well completed

1978 Filz... firm name

Lincoln county well located

LANDOWNER:

Keith Guy
P.R. Bogue Clitto
(mailing address)

description of formations encountered

from to

Red Clay 0 20
Red sand gravel 20 70
Coarse sand gravel 70 86

WELL LOCATION:

sec. 25 T 5 N R 9 E
S S W W
4 miles W of Ruth
(distance) (direction) (nearest town)

WELL PURPOSE:

(home, irrigation, municipal, industrial)

WELL COMPLETION DATA:

- (1) diameter (inches) 4
- (2) total depth (feet) 86
- (3) static water level (feet) 72 below above top of ground.
- (4) casing PVC, 78 (material), (depth)
4 (size) if telescope see back.
- (5) screen 8, 78 (length), (depth to top)
4, PVC (size), (material)
- (6) pump 1/2 (HP), 10 (yield gpm)
C (type power)
- (7) electric log 72 (yes or no)
(organization running log)
- (8) how well bottom plugged Sand block

DRILLERS REMARKS:


RECEIVED

JUN 23 1978

MISS. Bd. of WATER COMM.

If well telescopes please sketch and show depths.

GROUND LEVEL

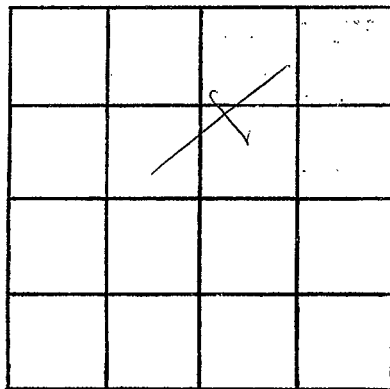

SECTION 25

Please indicate well location X.

ADDITIONAL INFORMATION

If more than one screen, show locations of each on sketch.