

LINCOLN

R 2011

8-26-78

MISSISSIPPI
 BOARD OF WATER COMMISSIONERS
 416 North State Street
 Jackson, Mississippi 39201

WATER WELL DRILLERS LOG

Aug - 26 1978 Reynolds & Son Lincoln
 date well completed firm name county well located

LANDOWNER:	description of formations encountered	from	to
<u>Paul Bristor</u>			
<u>Rt. Jones</u> (mailing address)	<u>red clay</u> <u>red sand</u> <u>sand & gravel</u>	<u>0</u> <u>18</u> <u>55</u>	<u>18</u> <u>55</u> <u>65</u>
WELL LOCATION:			
sec. <u>3</u> T <u>5</u> N R <u>9</u> E			
<u>11</u> miles <u>east</u> of <u>Boquetto</u> (distance) (direction) (nearest town)			
WELL PURPOSE: <u>house</u> (home, irrigation, municipal, industrial)			
WELL COMPLETION DATA:			
(1) diameter (inches) <u>4"</u>			
(2) total depth (feet) <u>65</u>			
(3) static water level (feet) <u>52'</u> below top of ground			
(4) casing <u>plastic bottom</u> (material) (depth)			
_____ if telescope see back. (size)			
(5) screen <u>5"</u> <u>60'</u> (length) (depth to top)			
<u>4"</u> <u>plastic</u> (size) (material)			
(6) pump <u>1/2</u> <u>10</u> (HP) (yield gpm)			
<u>elect</u> (type power)			
(7) electric log <u>no</u> (yes or no)			
_____ (organization running log)			
(8) how well bottom plugged <u>wooden plug</u>			
DRILLERS REMARKS: <u>L</u>			




JAN 15 1978

MISS. BD. OF WATER COMMISSIONERS

If well telescopes please
sketch and show depths.

GROUND LEVEL

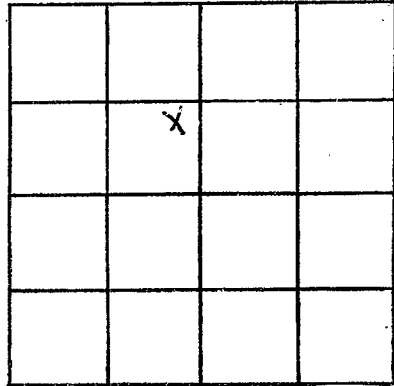

SECTION 3

Please indicate well location X.

ADDITIONAL INFORMATION

If more than one screen,
show locations of each on sketch.