

LINCOLN

R 2013

3/29/79

MISSISSIPPI BOARD OF WATER COMMISSIONERS
416 North State Street
Jackson, Mississippi 39201

WATER WELL DRILLERS LOG

March-29 1979 Reynolds Well Co Lincoln
date well completed firm name county well located

LANDOWNER:
J. B. Green
Rt Ruth
(mailing address)

description of formations encountered	from	to
<u>Red Clay</u>	<u>2</u>	<u>15</u>
<u>Red sand</u>	<u>45</u>	<u>50</u>
<u>pea gravel sand</u>	<u>50</u>	<u>74</u>

WELL LOCATION:
sec. 33 T. 6 N. R. 9 E
2 miles S-SE of Ruth
(distance) (direction) (nearest town)

WELL PURPOSE: Trailer
(home, irrigation, municipal, industrial)

WELL COMPLETION DATA:
(1) diameter (inches) 4"
(2) total depth (feet) 74
(3) static water level (feet) 40 below above top of ground.
(4) casing plastic bottom
(material) (depth)
_____ if telescope see back.
(size)
(5) screen 5' 69'
(length) (depth to top)
4" plastic
(size) (material)
(6) pump by other
(HP) (yield gpm)
unit
(type power)
(7) electric log no
(yes or no)

(organization running log)

(8) how well bottom plugged
wooden plug
DRILLERS REMARKS:


Miss. Board of Water Comm.

AUG 24 1979

RECEIVED

If well telescopes please sketch and show depths.

GROUND LEVEL

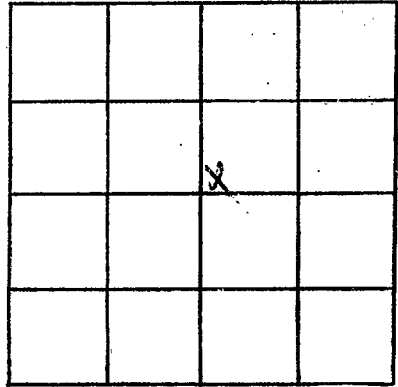

SECTION 33

Please indicate well location X.

ADDITIONAL INFORMATION

If more than one screen,
show locations of each on sketch.