

Lincoln  
 R 2014  
 ②  
 5-14-79

MISSISSIPPI  
 BOARD OF WATER COMMISSIONERS  
 416 North State Street  
 Jackson, Mississippi 39201

WATER WELL DRILLERS LOG

May 14 1979 Reynolds Lincoln  
 date well completed firm name county well located

LANDOWNER:  
James Alexander  
141 Ruth  
 (mailing address)

description of formations encountered	from to	
<u>Red clay gravel</u>	<u>0</u>	<u>17</u>
<u>Red sand</u>	<u>17</u>	<u>60</u>
<u>Chalk &amp; gravel</u>	<u>60</u>	<u>98</u>
<u>Gravel &amp; sand</u>	<u>98</u>	<u>110</u>

WELL LOCATION:  
 sec. 17 T. 33 N R. 9 E  
1 miles north of Ruth  
 (distance) (direction) (nearest town)

WELL PURPOSE: home  
 (home, irrigation, municipal, industrial)

WELL COMPLETION DATA:  
 (1) diameter (inches) 4"  
 (2) total depth (feet) 110  
 (3) static water level (feet) 75 below top of ground.  
 (4) casing plastic bottom  
 (material) (depth)  
 (size) If telescope see back.  
 (5) screen 57 105  
 (length) (depth to top)  
4" plastic  
 (size) (material)  
 (6) pump 1/2 10  
 (HP) (yield gpm)  
split  
 (type power)  
 (7) electric log no  
 (yes or no)  
 (organization running log)

(8) how well bottom plugged  
wooden plug  
 DRILLERS REMARKS:  
 \_\_\_\_\_


DEPT. OF NATURAL RESOURCES  
 BUREAU OF LAND & WATER RESOURCES

OCT 19 1979

RECEIVED

If well telescopes please sketch and show depths.

GROUND LEVEL

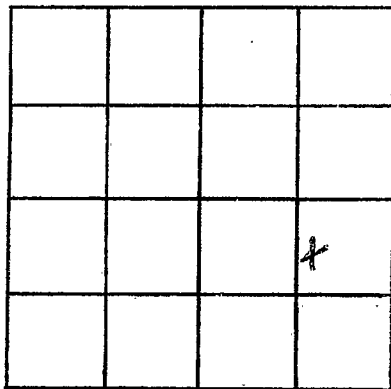

SECTION 17

Please indicate well location X.

ADDITIONAL INFORMATION

If more than one screen,  
show locations of each on sketch.