

Lincoln  
R 2018  
8-19-80

MISSISSIPPI  
 BOARD OF WATER COMMISSIONERS  
 416 North State Street  
 Jackson, Mississippi 39201

WATER WELL DRILLERS LOG

8-19

19 80

Hessell Well Co

Lincoln

date well completed

firm name

county well located

LANDOWNER:

Carl Rayburn

R.R. Jones  
 (mailing address)

description of formations encountered

from

to

<u>Red clay</u>	<u>0</u>	<u>20</u>
<u>White &amp; Blue clks</u>	<u>20</u>	<u>120</u>
<u>Coarse sand &amp; gravel</u>	<u>120</u>	<u>131</u>

WELL LOCATION:

sec. 24 T 5 N R 9 E  
 S W  
1 miles NE of Buster  
 (distance) (direction) (nearest town)

WELL PURPOSE: Home  
 (home, irrigation, municipal, industrial)

WELL COMPLETION DATA:

- (1) diameter (inches) 4
- (2) total depth (feet) 131
- (3) static water level (feet) 60 below above top of ground.
- (4) casing PVC, 123,  
 (material) (depth)  
4 if telescope see back.  
 (size)
- (5) screen 8, 123  
 (length) (depth to top)  
4, PVC  
 (size) (material)
- (6) pump 1/2, 10  
 (HP) (yield gpm)  
Gas  
 (type power)
- (7) electric log No  
 (yes or no)  
 (organization running log)
- (8) how well bottom plugged Seal

DRILLERS REMARKS:


DEPT. OF NATURAL RESOURCES  
 BUREAU OF LAND & WATER RESOURCES

SEP 8 1980

RECEIVED

If well telescopes please sketch and show depths.

GROUND LEVEL

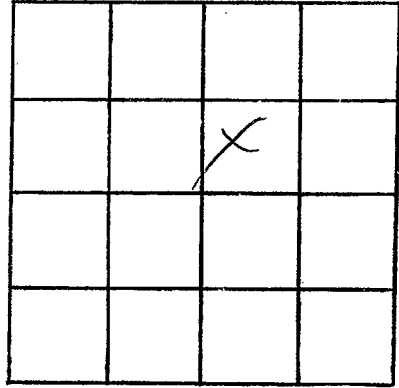

SECTION 24

Please indicate well location X.

ADDITIONAL INFORMATION

If more than one screen, show locations of each on sketch.