

Lincoln
R 2021
10-22-81

MISSISSIPPI DEPARTMENT OF NATURAL RESOURCES
Bureau of Land and Water Resources
Southport Mall
P.O. Box 10631
Jackson, Mississippi 39209
WATER WELL DRILLERS LOG

Oct. 22 19 81 Grenn Water Well Cont. Lincoln
date well completed firm name county well located

LANDOWNER: E. J. Hodges Route 1, Box 24 Ruth, Ms. (mailing address)	description of formations encountered	from	to
	Citronelle	1	100
WELL LOCATION:			
sec. 26 T 5 N R 9 E S W			
9 miles SE of Brookhaven (distance) (direction) (nearest town)			
WELL PURPOSE: home (home, irrigation, municipal, industrial)			
WELL COMPLETION DATA:			
(1) diameter (inches) 4			
(2) total depth (feet) 100			
(3) static water level (feet) 70 below above top of ground.			
(4) casing PVC 90' (material) (depth) 4" if telescope see back. (size)			
(5) screen 100' 90' (length) (depth to top) .010 PVC (size) (material)			
(6) pump 1/2 sub 8 (HP) (yield gpm) electricity (type power)			
(7) electric log no (yes or no) (organization running log)			
(8) how well bottom plugged back wash valve			
DRILLERS REMARKS:			


DEPT. OF NATURAL RESOURCES
BUREAU OF LAND & WATER RESOURCES

DEC 11 1981

RECEIVED

If well telescopes please sketch and show depths.

GROUND LEVEL

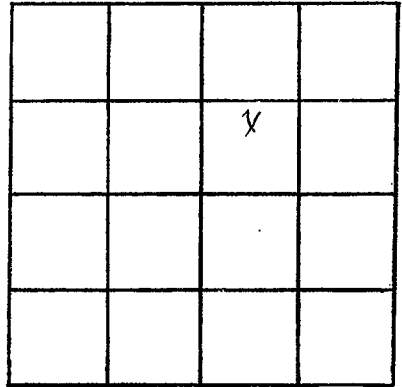

SECTION 26

Please indicate well location X.

ADDITIONAL INFORMATION

If more than one screen,
show locations of each on sketch.