

Lincoln
R 2020
10-30-81

MISSISSIPPI DEPARTMENT OF NATURAL RESOURCES
Bureau of Land and Water Resources
Southport Mall
P.O. Box 10631
Jackson, Mississippi 39209
WATER WELL DRILLERS LOG

Oct. 30 1981 Grenn Water Well Cont. Lincoln
date well completed firm name county well located

LANDOWNER: Rachel Pater Box 2 Ruth, Ms. (mailing address)	description of formations encountered Citrnelle	from 1	to 86
WELL LOCATION:			
sec. <u>24</u> T- <u>5</u> ^N / _S R- <u>9</u> ^E / _W			
9 miles SE of Bogue (hitto) (distance) (direction) (nearest town)			
WELL PURPOSE: <u>home</u> (home, irrigation, municipal, industrial)			
WELL COMPLETION DATA:			
(1) diameter (inches) <u>4</u>			
(2) total depth (feet) <u>86</u>			
(3) static water level (feet) <u>58</u> below above top of ground.			
(4) casing <u>PVC</u> <u>76'</u> (material) (depth) <u>4"</u> (size) if telescope see back.			
(5) screen <u>10'</u> <u>76'</u> (length) (depth to top) <u>.010</u> <u>PVC</u> (size) (material)			
(6) pump <u>1/2 sub</u> <u>8</u> (HP) (yield gpm) <u>electricity</u> (type power)			
(7) electric log <u>no</u> (yes or no) <u></u> (organization running log)			
(8) how well bottom plugged <u>back wash valve</u>			
DRILLERS REMARKS:			


DEPT. OF NATURAL RESOURCES
BUREAU OF LAND & WATER RESOURCES

DEC 11 1981

RECEIVED

If well telescopes please sketch and show depths.

GROUND LEVEL

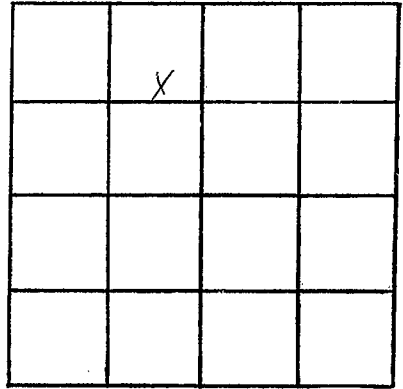

SECTION 24

Please indicate well location X.

ADDITIONAL INFORMATION

If more than one screen,
show locations of each on sketch.