

MISSISSIPPI DEPARTMENT OF NATURAL RESOURCES

Bureau of Land and Water Resources

Southport Mall

P.O. Box 10631

Jackson, Mississippi 39209

WATER WELL DRILLERS LOG

Lincoln
R 2025

July 30 1981 Reems well service Lincoln
date well completed firm name county well located

LANDOWNER:	description of formations encountered	from	to
<u>Pat Rutland</u> <u>St Ruth</u> (mailing address)	<u>red clay</u>	<u>0</u>	<u>20</u>
	<u>pink chert</u>	<u>20</u>	<u>45</u>
	<u>red shell gravel</u>	<u>45</u>	<u>95</u>
	<u>+ sand</u>	<u>0</u>	
	<u>sand + pebbles</u>	<u>95</u>	<u>102</u>
WELL LOCATION: sec <u>28</u> T <u>5</u> N R <u>9</u> E <u>1</u> miles <u>S-SE</u> of <u>Ruth</u> (distance) (direction) (nearest town)			
WELL PURPOSE: <u>irrigation</u> (home, irrigation, municipal, industrial)			
WELL COMPLETION DATA:			
(1) diameter (inches) <u>4"</u>			
(2) total depth (feet) <u>102'</u>			
(3) static water level (feet) <u>80'</u> above top of ground			
(4) casing <u>plastic bottom</u> (material) (depth)			
_____ if telescope see back. (size)			
(5) screen <u>5'</u> <u>97'</u> (length) (depth to top)			
(6) pump <u>1/2</u> <u>plastic</u> (size) (material)			
(6) pump <u>1/2</u> <u>10</u> (HP) (yield gpm)			
(6) pump <u>1/2</u> (type power)			
(7) electric log <u>no</u> (yes or no)			
_____ (organization running log)			
(8) how well bottom plugged <u>back wash above</u>			
DRILLERS REMARKS:			


DEPT OF NATURAL RESOURCES
BUREAU OF LAND & WATER RESOURCES

FEB - 8 1982

RECEIVED

If well telescopes please sketch and show depths.

GROUND LEVEL

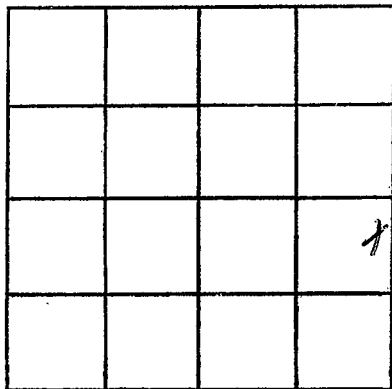

SECTION 28

Please indicate well location X.

ADDITIONAL INFORMATION

If more than one screen, show locations of each on sketch.