

Lincoln  
R  
2028

MISSISSIPPI DEPARTMENT OF NATURAL RESOURCES  
Bureau of Land and Water Resources  
Southport Mall  
P.O. Box 10631  
Jackson, Mississippi 39209  
WATER WELL DRILLERS LOG

July 27, 1982 Grenn Water Well Lincoln  
date well completed firm name county well located

LANDOWNER: Bessie Boyd  
Route 1, Box 215  
Jayess, Ms.  
(mailing address)

description of formations encountered	from	to
clay	1	20
sand & gravel	20	90
white clay	90	95
blue clay	95	130
sand	130	150

WELL LOCATION:  
sec. 24 T 5 N R 9 E  
S W  
13 miles SE of Bogue Chitto  
(distance) (direction) (nearest town)

WELL PURPOSE: home  
(home, irrigation, municipal, industrial)

WELL COMPLETION DATA:

- (1) diameter (inches) 4
- (2) total depth (feet) 150
- (3) static water level (feet) 52 below above top of ground.
- (4) casing PVC 140  
(material) (depth)  
4" if telescope see back.  
(size)
- (5) screen 10' 140'  
(length) (depth to top)  
.010 PVC  
(size) (material)
- (6) pump 1/2 sub 10  
(HP) (yield gpm)  
electricity  
(type power)
- (7) electric log no  
(yes or no)  
  
(organization running log)
- (8) how well bottom plugged back wash valve

DRILLERS REMARKS:


DEPT. OF NATURAL RESOURCES  
BUREAU OF LAND & WATER RESOURCES

AUG 23 1982

RECEIVED

If well telescopes please sketch and show depths.

GROUND LEVEL

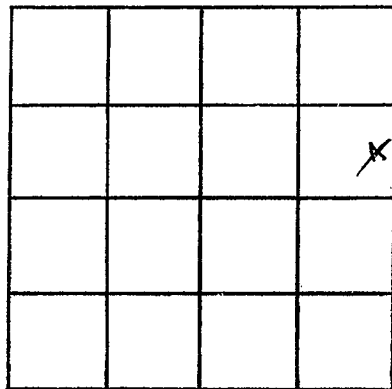

SECTION 24

Please indicate well location X.

ADDITIONAL INFORMATION

If more than one screen,  
show locations of each on sketch.