

Lincoln
R R
2029

MISSISSIPPI DEPARTMENT OF NATURAL RESOURCES
Bureau of Land and Water Resources
Southport Mall
P.O. Box 10631
Jackson, Mississippi 39209
WATER WELL DRILLERS LOG

Sept. 30 1982 Gretn Water Well Lincoln
date well completed firm name county well located

LANDOWNER: Pat Ard
Rt. 1, Box 213A
Jayess, Ms. 39641
(mailing address)

description of formations
encountered
Citronelle
from 1 to 120

WELL LOCATION:
sec. 25 T 5 N R 9 E
S W
12 miles SE of Bogue Chitto
(distance) (direction) (nearest town)

WELL PURPOSE: home
(home, irrigation, municipal, industrial)

WELL COMPLETION DATA:
(1) diameter (inches) 4
(2) total depth (feet) 120
(3) static water level (feet) 60 below above
top of ground.
(4) casing PVC, 110
(material) (depth)
4" if telescope see back.
(size)
(5) screen 10' 110'
(length) (depth to top)
.010 PVC
(size) (material)
(6) pump 1/2 sub 8
(HP) (yield gpm)
electricity
(type power)
(7) electric log no
(yes or no)
(organization running log)

(8) how well bottom plugged
back wash valve


DEPT. OF NATURAL RESOURCES
BUREAU OF LAND & WATER RESOURCES
NOV 23 1982

DRILLERS REMARKS:

RECEIVED

If well telescopes please sketch and show depths.

GROUND LEVEL

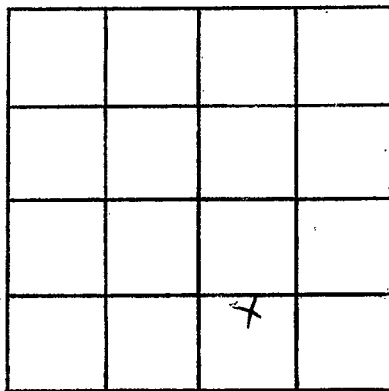

SECTION 25

Please indicate well location X.

ADDITIONAL INFORMATION

If more than one screen, show locations of each on sketch.