

Lincoln
 R
 2030

MISSISSIPPI DEPARTMENT OF NATURAL RESOURCES
 Bureau of Land and Water Resources
 Southport Mall
 P.O. Box 10631
 Jackson, Mississippi 39209
 WATER WELL DRILLERS LOG

9-21-83 19 Grenn Water Well Lincoln
 date well completed firm name county well located

LANDOWNER: Benjo Williams
 1302 N. Jackson
 Brookhaven, Ms
 (mailing address)

description of fomations
 encountered from to
 Catronelle 1 99

WELL LOCATION:
 sec. 3 T 5 N R 9 E
 S W
 10 miles E of Bogue Chitto
 (distance) (direction) (nearest town)

WELL PURPOSE: home
 (home, irrigation, municipal, industrial)

- WELL COMPLETION DATA:
- (1) diameter (inches) 4
 - (2) total depth (feet) 99
 - (3) static water level (feet) 60 below above top of ground.
 - (4) casing PVC, 89',
 (material) (depth),
 4" if telescope see back.
 (size)
 - (5) screen 10', 89',
 (length) (depth to top),
 4" PVC
 (size) (material)
 - (6) pump 1/2 sub 8
 (HP) (yield gpm)
 electricity
 (type power)
 - (7) electric log no
 (yes or no)
 (organization running log)
 - (8) how well bottom plugged back wash valve


DEPT. OF NATURAL RESOURCES
 BUREAU OF LAND & WATER RESOURCES

NOV -7 1983
RECEIVED

DRILLERS REMARKS:

If well telescopes please sketch and show depths.

GROUND LEVEL

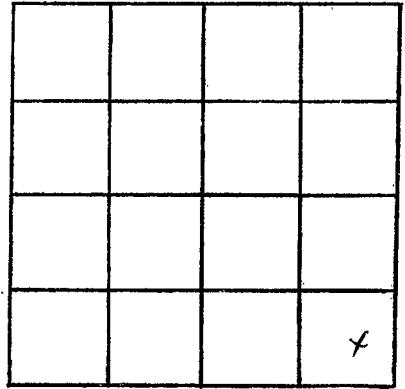

SECTION 3

Please indicate well location X.

ADDITIONAL INFORMATION

If more than one screen,
show locations of each on sketch.