

MISSISSIPPI DEPARTMENT OF NATURAL RESOURCES  
Bureau of Land and Water Resources  
Southport Mall  
P.O. Box 10631  
Jackson, Mississippi 39209  
WATER WELL DRILLERS LOG

*Leaders*  
R  
2032

Aug. 6 1984 Grenn Water Well Lincoln  
date well completed firm name county well located

LANDOWNER: Stanley Lawrence

Route 1, Box 212A

Jayess, Ms.

(mailing address)

description of formations  
encountered

Citronelle

from

1

to

122

WELL LOCATION:

sec. 35 T. 5 N. R. 9 E. S. W.  
12 miles SE of Bogie Chitto  
(distance) (direction) (nearest town)

WELL PURPOSE: home  
(home, irrigation, municipal, industrial)

WELL COMPLETION DATA:

- (1) diameter (inches) 4  
(2) total depth (feet) 122  
(3) static water level (feet) 92 below top of ground.  
(4) casing PVC 112 (material), (depth), 4" (size) if telescope see back.  
(5) screen 10' 1120 (length), (depth to top), .010 PVC (size), (material)  
(6) pump 3/4 sub 8 (HP), (yield gpm)  
electricity (type power)  
(7) electric log no (yes or no)

(organization running log)


(8) how well bottom plugged back wash valve

DRILLERS REMARKS:

DEPT. OF NATURAL RESOURCES  
BUREAU OF LAND & WATER RESOURCES  
SEP 18 1984  
RECEIVED

If well telescopes please sketch and show depths.

GROUND LEVEL

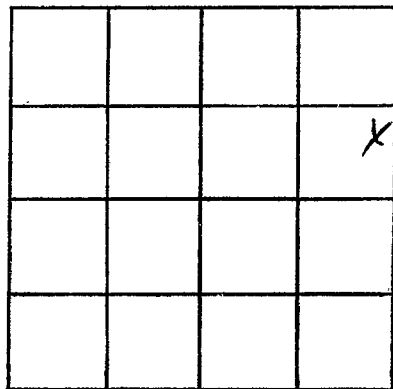

SECTION 35

Please indicate well location X.

ADDITIONAL INFORMATION

If more than one screen,  
show locations of each on sketch.