

MISSISSIPPI DEPARTMENT OF NATURAL RESOURCES

Bureau of Land and Water Resources

Southport Mall

P.O. Box 10631

Jackson, Mississippi 39209

WATER WELL DRILLERS LOG

Lincoln
R 2034
1-23-85

Jan 23 1985 Remme Well Ser Lincoln
date well completed firm name county well located


LANDOWNER:	description of formations encountered	from	to
<u>Mark Batt</u>			
<u>Rt Ruth</u> (mailing address)	<u>clay</u> <u>sand & gravel</u>	<u>0</u> <u>18</u>	<u>18</u> <u>62</u>
WELL LOCATION:			
sec. <u>9</u> T. <u>5</u> N R. <u>9</u> E <u>3</u> miles <u>north</u> of <u>Ruth</u> (distance) (direction) (nearest town)			
WELL PURPOSE: <u>Tractor</u> (home, irrigation, municipal, industrial)			
WELL COMPLETION DATA:			
(1) diameter (inches) <u>4"</u>			
(2) total depth (feet) <u>62</u>			
(3) static water level (feet) <u>30</u> below top of ground.			
(4) casing <u>plastic, battlon</u> (material) (depth)			
_____ If telescope see back. (size)			
(5) screen <u>5'</u> , <u>57'</u> (length) (depth to top)			
<u>4"</u> , <u>plastic</u> (size) (material)			
(6) pump <u>weather</u> (HP) (yield gpm)			
<u>1/2 HP</u> (type power)			
(7) electric log <u>no</u> (yes or no)			
_____ (organization running log)			
(8) how well bottom plugged <u>both ends</u>			
DRILLERS REMARKS: _____			

RECEIVED
JUN 27 1985

Department of Natural Resources
Bureau of Land & Water Resources

If well telescopes please sketch and show depths.

GROUND LEVEL

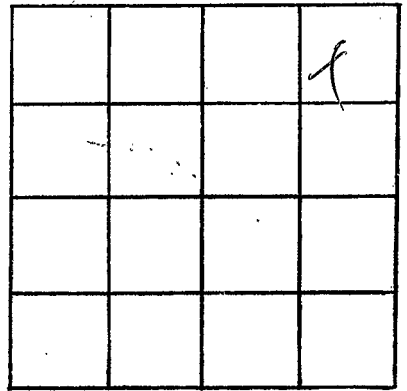

SECTION 7

Please indicate well location X.

ADDITIONAL INFORMATION

If more than one screen,
show locations of each on sketch.