

MISSISSIPPI DEPARTMENT OF NATURAL RESOURCES
 Bureau of Land and Water Resources
 Southport Mall
 P.O. Box 10631
 Jackson, Mississippi 39209
WATER WELL DRILLERS LOG

Lincoln
R 2035

10-21 1985 Grenn Water Well Lincoln
 date well completed firm name county well located

LANDOWNER: Kay Mason
Rt. 1, Box 177
Ruth, Ms.
 (mailing address)

description of formations encountered	from	to
	<u>Citronelle</u>	<u>1</u>

WELL LOCATION:
 sec. 29 T. 5 N R. 9 E
9 SE W Bogue Chitto,
 (distance) miles (direction) of (nearest town)

WELL PURPOSE: home
 (home, irrigation, municipal, industrial)


- WELL COMPLETION DATA:
- (1) diameter (inches) 4
 - (2) total depth (feet) 147
 - (3) static water level (feet) 65 below above top of ground.
 - (4) casing PVC 137'
 (material) (depth)
4"
 (size) if telescope see back.
 - (5) screen 10' 137'
 (length) (depth to top)
.010 PVC
 (size) (material)
 - (6) pump did not install
 (HP) (yield gpm)
 (type power)
 - (7) electric log no
 (yes or no)
 (organization running log)
 - (8) how well bottom plugged back wash valve

DRILLERS REMARKS:

RECEIVED
 NOV - 4 1985

If well telescopes please sketch and show depths.

GROUND LEVEL

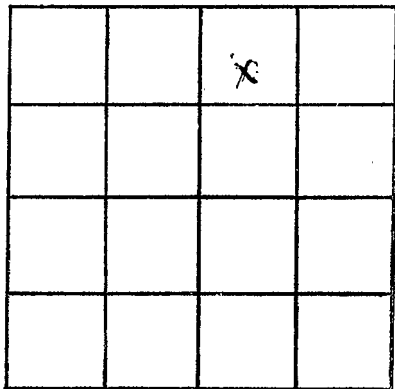

SECTION 29

Please indicate well location X.

ADDITIONAL INFORMATION

If more than one screen,
show locations of each on sketch.