

MISSISSIPPI DEPARTMENT OF NATURAL RESOURCES

Bureau of Land and Water Resources

Southport Mall

P.O. Box 10631

Jackson, Mississippi 39209

WATER WELL DRILLERS LOG

LINCOLN
R 2036


Mar. 31 19 86 Green Water Well Lincoln
date well completed firm name county well located

LANDOWNER: <u>Mikall Boyd</u> Rt. 1	description of formations encountered	from	to
<u>Ruth, Ms.</u> (mailing address)	<u>Citronelle</u>	<u>1</u>	<u>83</u>
WELL LOCATION:			
sec. <u>27</u> <u>5</u> N R <u>9</u> E S W <u>9</u> miles <u>SE</u> of <u>Bogue Chitto</u> (distance) (direction) (nearest town)			
WELL PURPOSE: <u>home</u> (home, irrigation, municipal, industrial)			
WELL COMPLETION DATA:			
(1) diameter (inches) <u>4</u>			
(2) total depth (feet) <u>83</u>			
(3) static water level (feet) <u>35</u> below above top of ground.			
(4) casing <u>PVC</u> , <u>73</u> , (material) (depth) <u>4</u> If telescope see back. (size)			
(5) screen <u>10'</u> , <u>73'</u> (length) (depth to top) <u>.010</u> , <u>PVC</u> (size) (material)			
(6) pump <u>did not install</u> (HP) (yield gpm)			
(type power)			
(7) electric log <u>no</u> (yes or no)			
(organization running log)			
(8) how well bottom plugged <u>back wash valve</u>			
DRILLERS REMARKS:			

RECEIVED
APR 2 1986
Department of Natural Resources
Bureau of Land & Water Resources

If well telescopes please sketch and show depths.

GROUND LEVEL

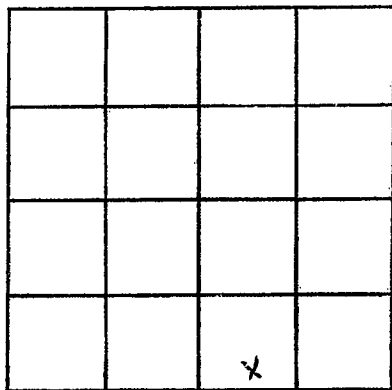

SECTION 27

Please indicate well location X.

ADDITIONAL INFORMATION

If more than one screen,
show locations of each on sketch.