

MISSISSIPPI DEPARTMENT OF NATURAL RESOURCES

Bureau of Land and Water Resources

Southport Mall

P.O. Box 10631

Jackson, Mississippi 39209

WATER WELL DRILLERS LOG

LINCOLN  
R 237

Oct 7 1985  
date well completed

85 Rivers Well Co.  
firm name

Lincoln  
county well located


LANDOWNER:  
Eloyd Jenkins  
Rt 1 Ruth  
(mailing address)

description of formations encountered	from	to
Red Clay	0	22
Red sand	22	68
sand & gravel	68	80
clay & sand	80	110
sand & gravel	110	138

WELL LOCATION:  
sec. 32 T. 5 N R. 9 E  
2 miles South of Ruth  
(distance) (direction) (nearest town)

WELL PURPOSE: house  
(home, irrigation, municipal, industrial)

- WELL COMPLETION DATA:
- (1) diameter (inches) 12"
  - (2) total depth (feet) 138
  - (3) static water level (feet) 90 below top of ground
  - (4) casing plastic bottom  
(material) (depth)
  - (5) screen 5' 133'  
(length) (depth to top)  
4" (size) plastic (material)
  - (6) pump 2 HP 10 (yield gpm)  
West (type power)
  - (7) electric log no (yes or no)
  - (8) how well bottom plugged backwash

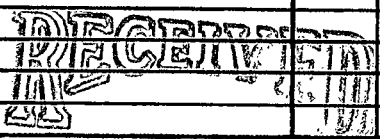


JUL 01 1986

Department of Natural Resources  
Bureau of Land & Water Resources

DRILLERS REMARKS:

If well telescopes please  
sketch and show depths.

GROUND LEVEL

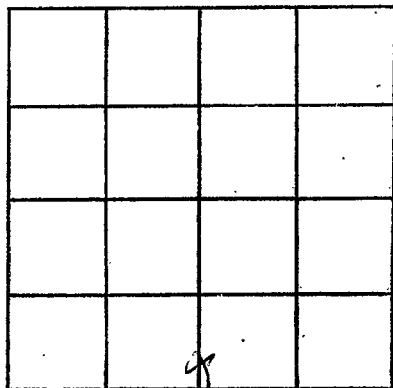

SECTION 32

Please indicate well location X.

ADDITIONAL INFORMATION

If more than one screen,  
show locations of each on sketch.