

MISSISSIPPI DEPARTMENT OF NATURAL RESOURCES

Bureau of Land and Water Resources

Southport Mall

P.O. Box 10631

Jackson, Mississippi 39209

WATER WELL DRILLERS LOG

| |
|---------|
| LINCOLN |
| R |
| 2038 |

May 21 19 86 Grenn Water Well Lincoln
 date well completed firm name county well located


LANDOWNER: Eldon M. Greer
 Route 1
 Ruth, Ms.
 (mailing address)

| description of formations encountered | from | to |
|---------------------------------------|------|-----|
| Citronelle | 1 | 128 |

WELL LOCATION:
 sec. 11 T 5 N R 9 E
 S W
 10 miles SE of Bogue Chitto
 (distance) (direction) (nearest town)

WELL PURPOSE: home
 (home, irrigation, municipal, industrial)

- WELL COMPLETION DATA:
- (1) diameter (inches) 4
 - (2) total depth (feet) 128
 - (3) static water level (feet) 36 below above top of ground.
 - (4) casing PVC 118
 (material) (depth)
 4" if telescope see back.
 (size)
 - (5) screen 10' 118'
 (length) (depth to top)
 .010 PVC
 (size) (material)
 - (6) pump did not install
 (HP) (yield gpm)
 (type power)
 - (7) electric log no
 (yes or no)
 (organization running log)
 - (8) how well bottom plugged
 back wash valve

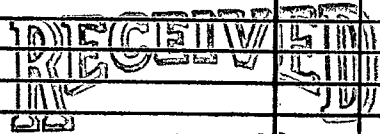


JUN 27 1986
 Department of Natural Resources
 Bureau of Land & Water Resources

DRILLERS REMARKS:

If well telescopes please sketch and show depths.

GROUND LEVEL

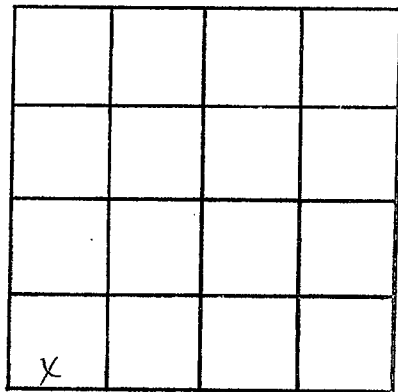

SECTION 11

Please indicate well location X.

ADDITIONAL INFORMATION

If more than one screen,
show locations of each on sketch.